

119° 107' 30"

See Page 4

119° 00' 00"

119° 15' 00"

See Page 6

See Page 8

**ROAD 655  
WIDTH = 40'**

**LEGALIZATION 2004  
WIDTH = 40'**

**STANFIELD**  
Pop. 1,875  
See Detail Map of City of Stanfield Page 68

R29


See Page 10

R30

7

ROAD 655  
WIDTH = 40'

LEGALIZATION 2004  
WIDTH = 40'

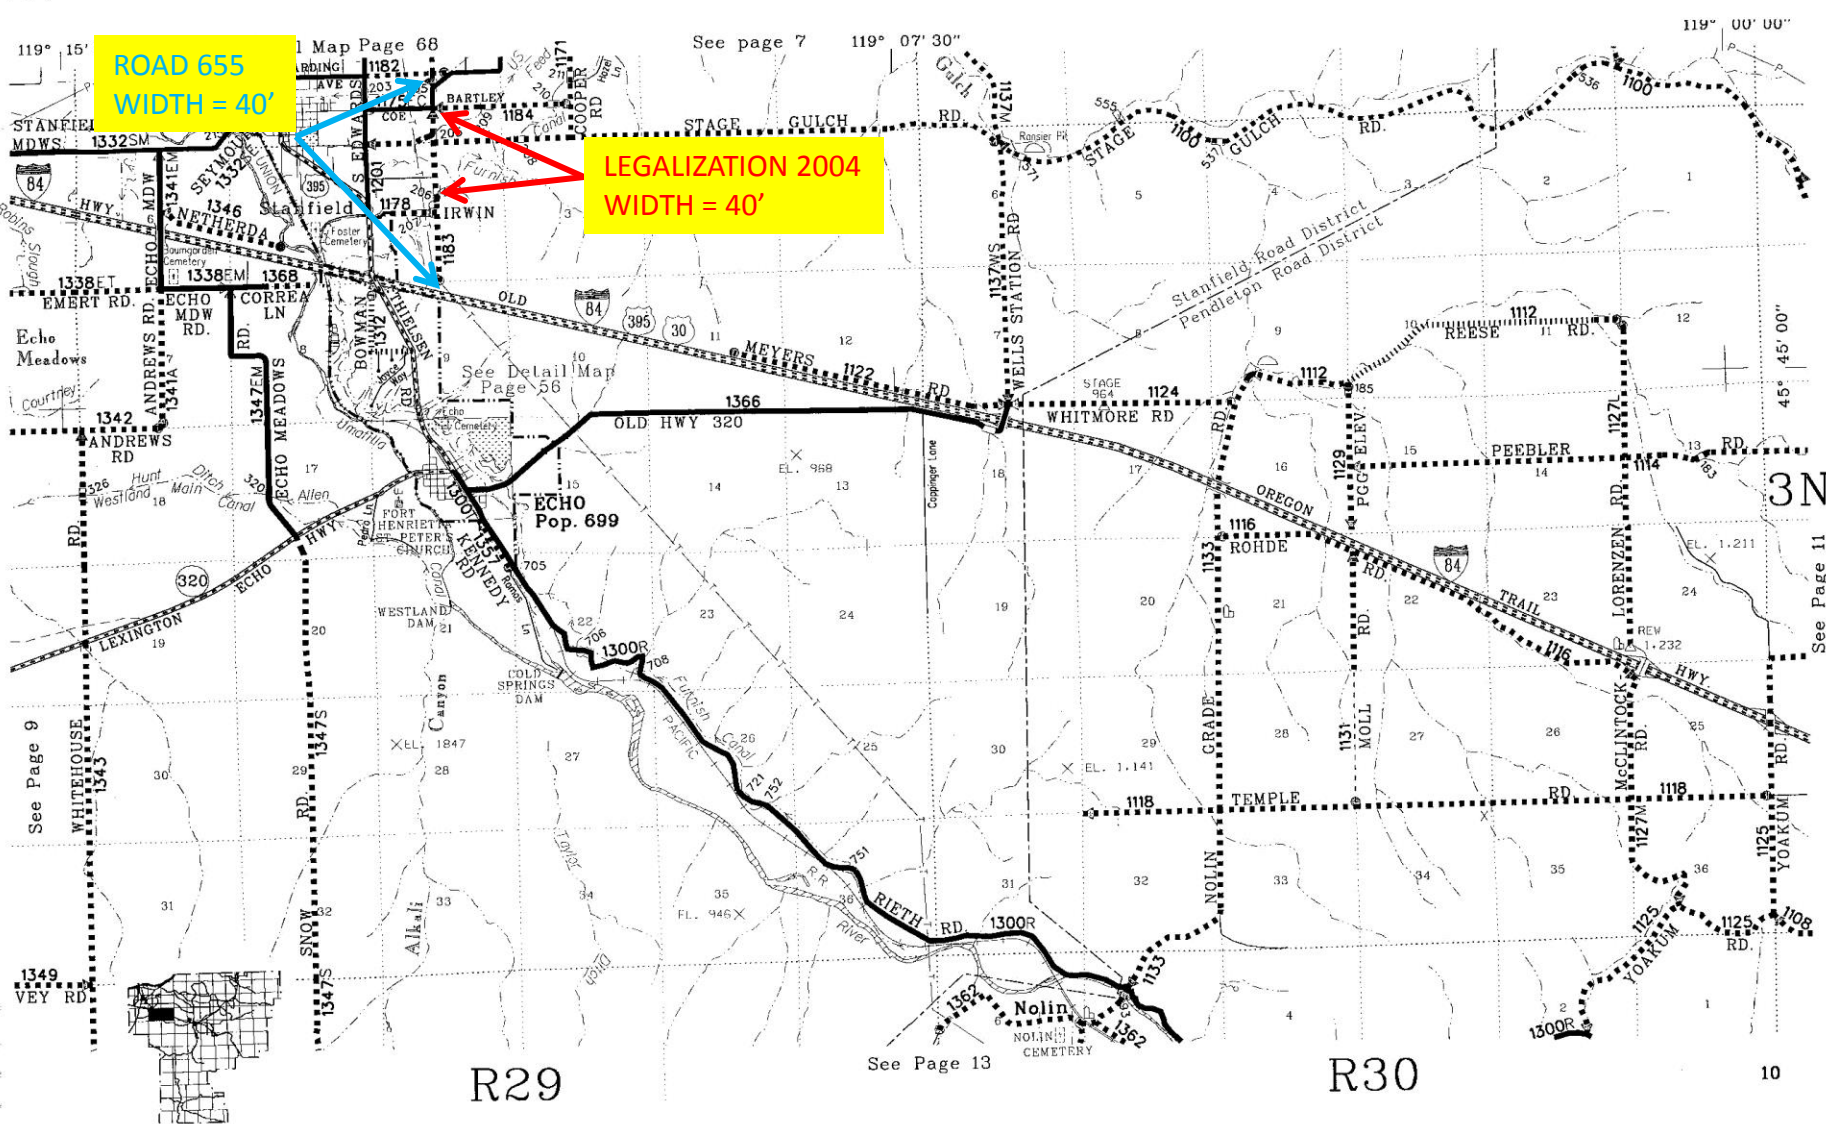

R29

See Page 13

R30

10