


WASHINGTON

STATE

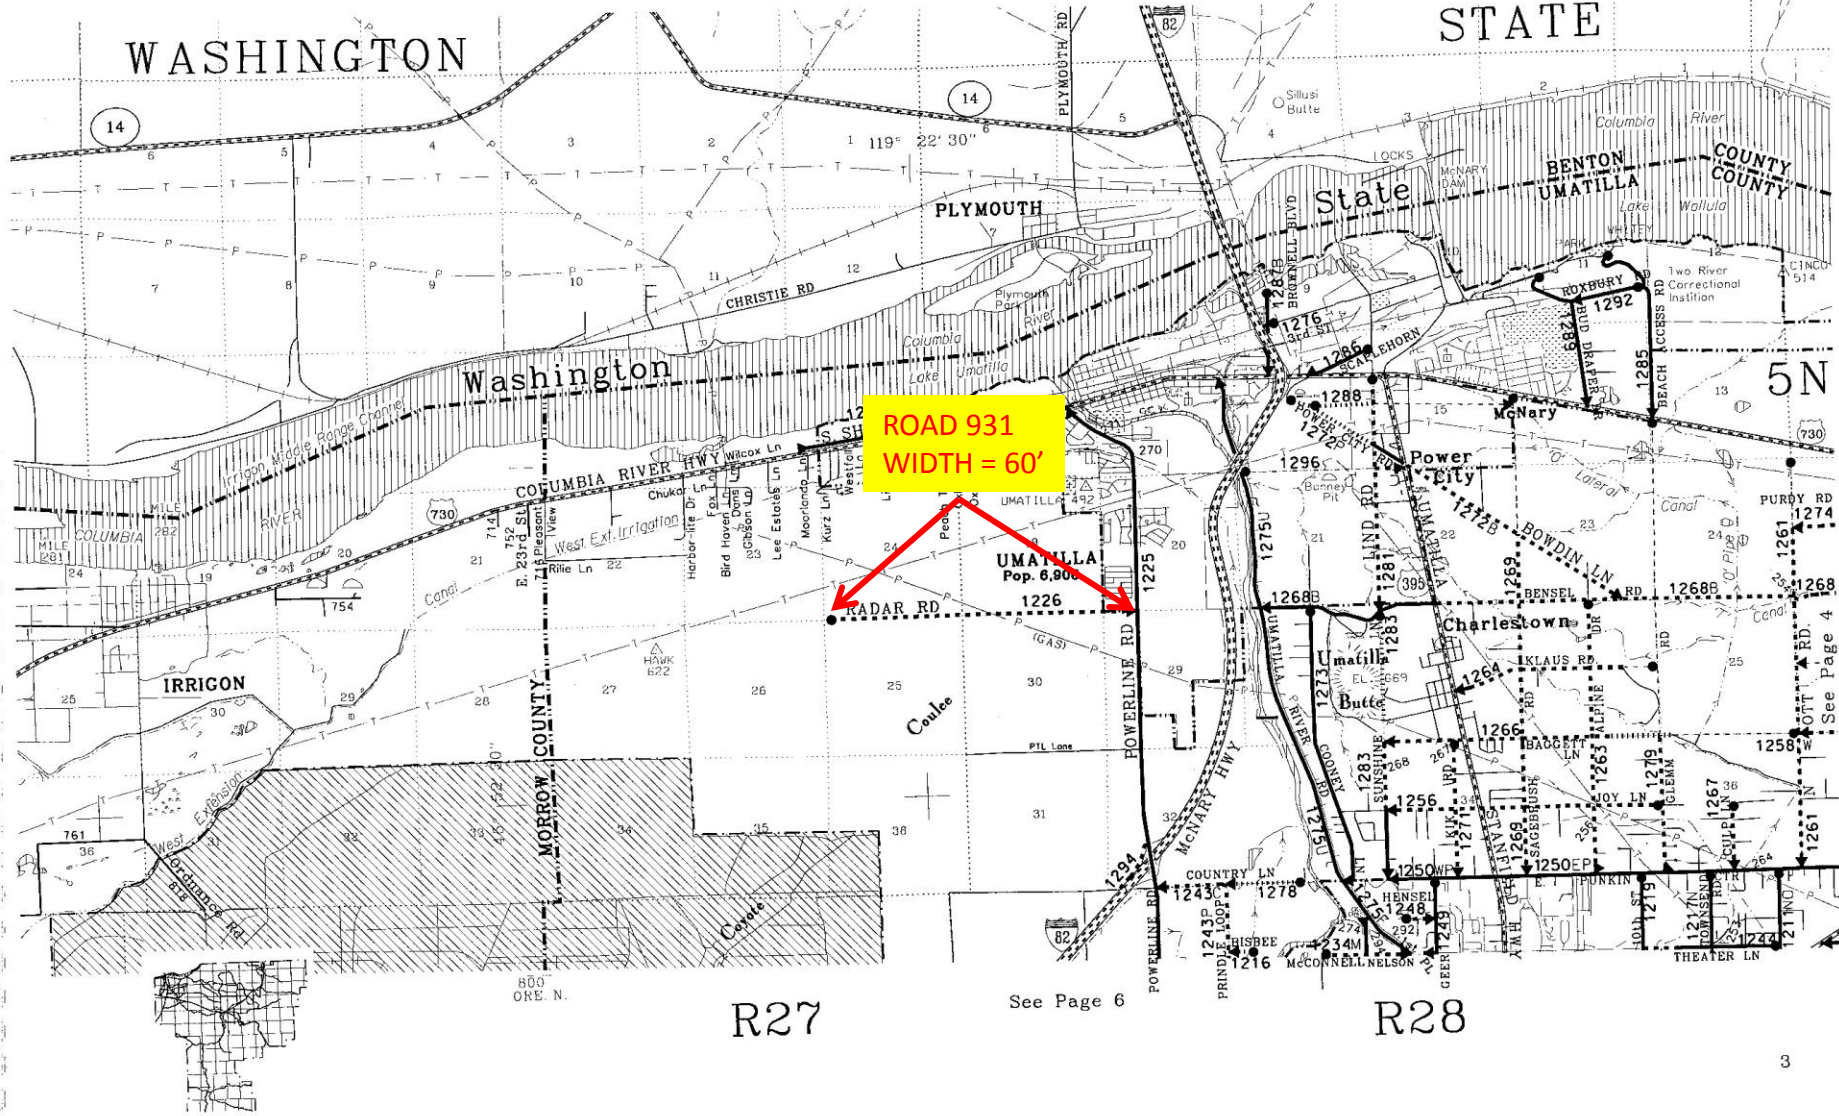

**ROAD 931
WIDTH = 60'**

See Page 6

R27

R28