


PLAT OF COUNTY ROAD No. 705  
INT. 4 N. R. 28 E. W. M.

SURVEYED MAY 19 1911  
Scale 25 Chs. = 1 In.

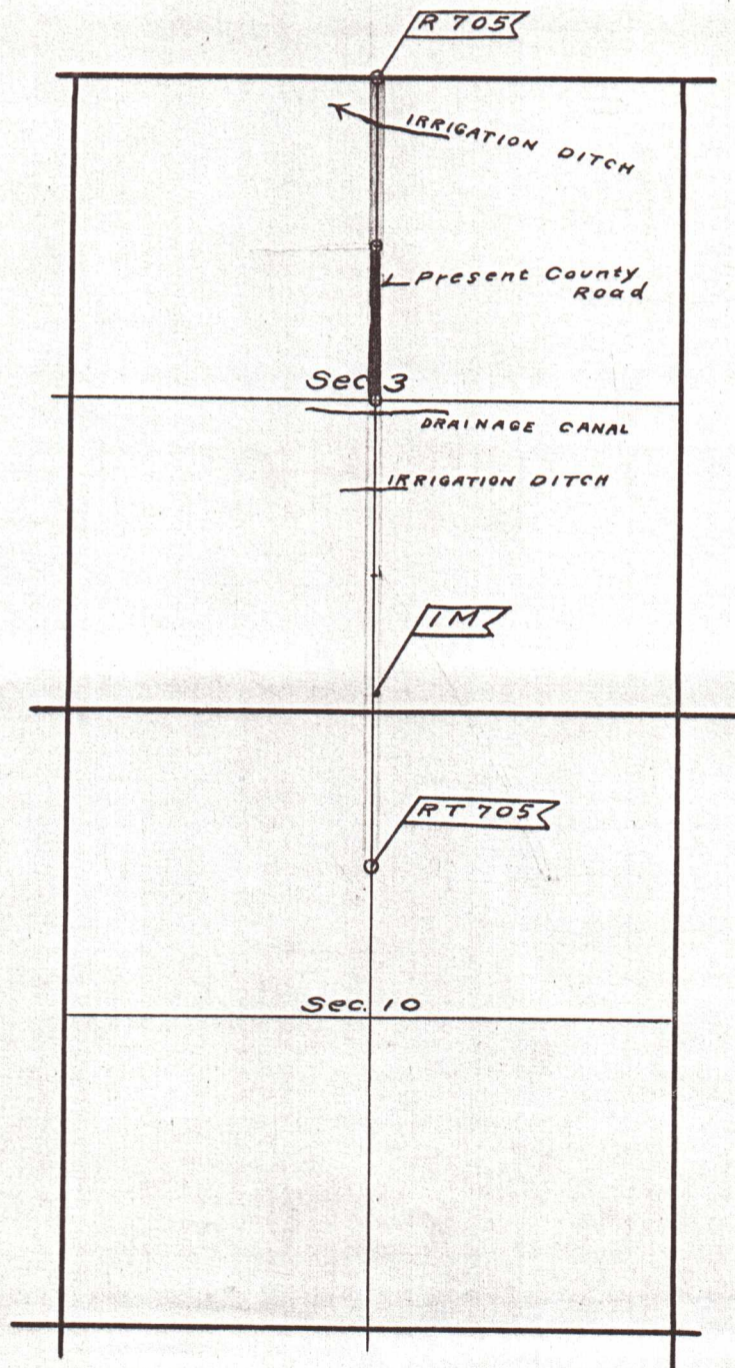

Geary Kimbrell  
County Surveyor