


PLAT OF COUNTY ROAD No. 752
INT. 5 N. R. 29 E. W. M.

SURVEYED JUNE 2 1913
Scale 25 chs. = 1 in.

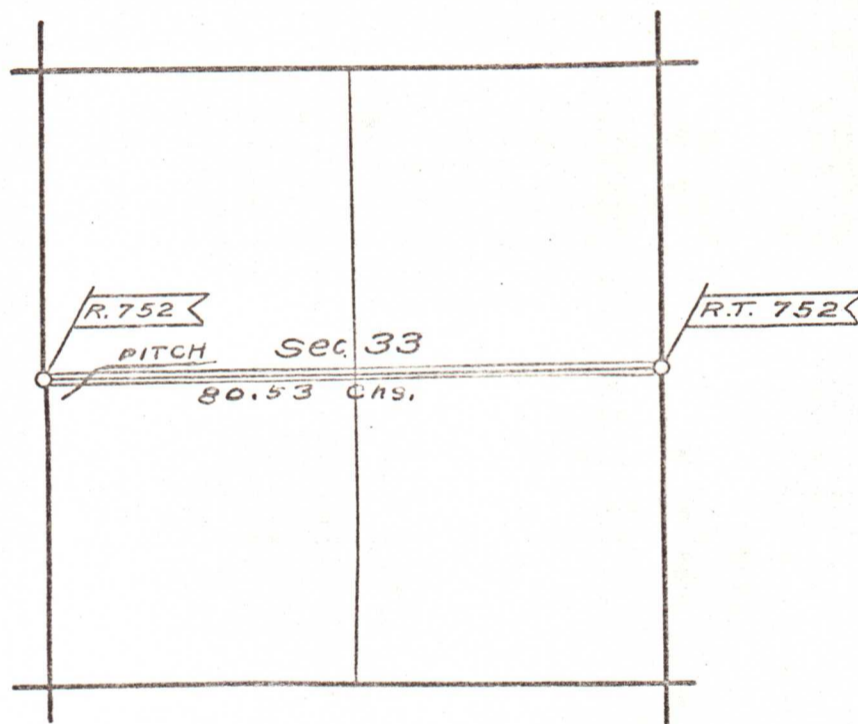

Geary Kimbrell
County Surveyor