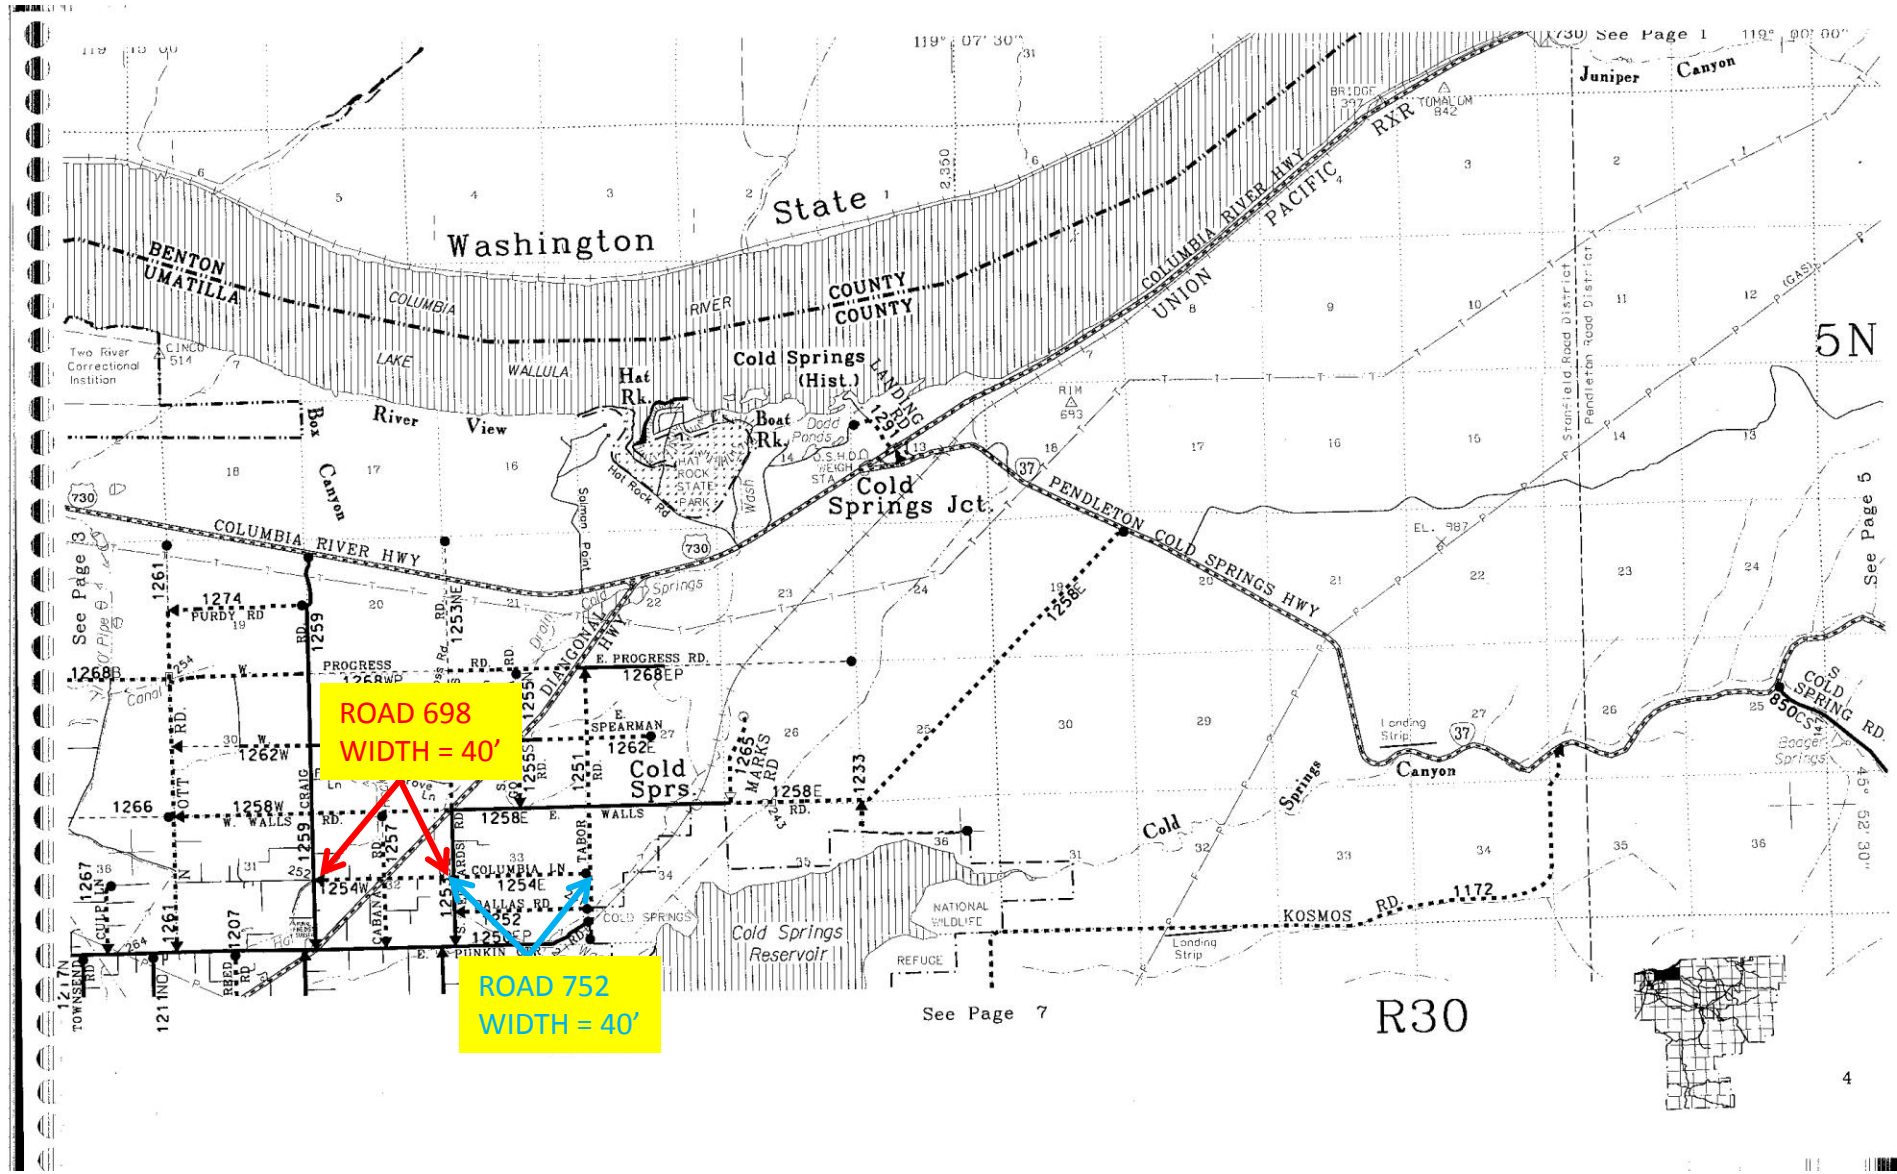

ROAD 698
WIDTH = 40'
ROAD 752
WIDTH = 40'
Washington State
BENTON COUNTY
UMATILLA COUNTY
COLUMBIA RIVER
LAKE WALLULA
Cold Springs (Hist.)
Hat Rk.
Boat Rk.
Cold Springs Jct.
Cold Sprs.
Cold Springs Reservoir
COLUMBIA RIVER HWY
PENDLETON COLD SPRINGS HWY
UNION PACIFIC RXR
Juniper Canyon
Box Canyon
River View
Two River Correctional Institution
Hat Rock State Park
Dodd Ponds
Salmon Point
Cold Springs
Cold Springs Canyon
Landing Strip
KOSMOS RD.
NATIONAL WILDLIFE REFUGE
Stanfield Road District
Pendleton Road District
See Page 1
See Page 3
See Page 5
See Page 7
5N
R30