


WASHINGTON

STATE

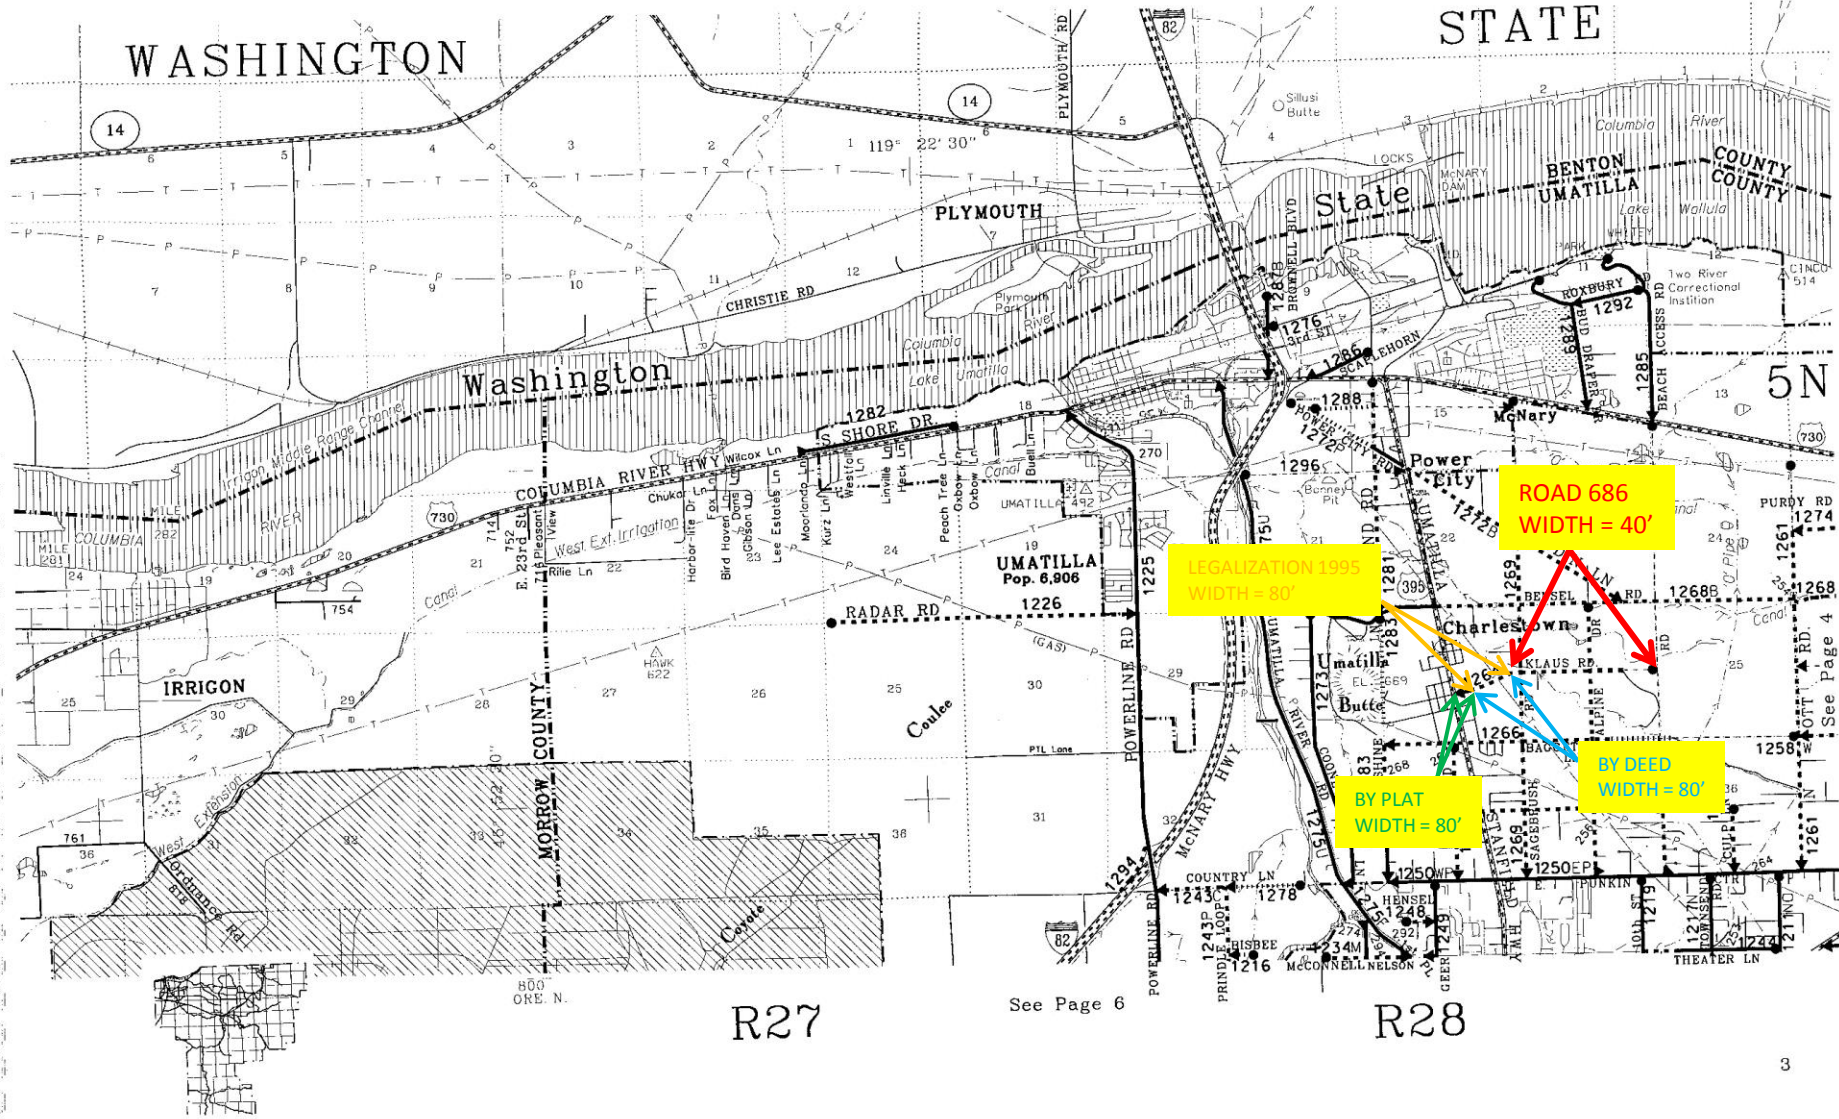

ROAD 686
WIDTH = 40'

LEGALIZATION 1995
WIDTH = 80'

BY PLAT
WIDTH = 80'

BY DEED
WIDTH = 80'

R27

R28

See Page 6