


WASHINGTON

STATE

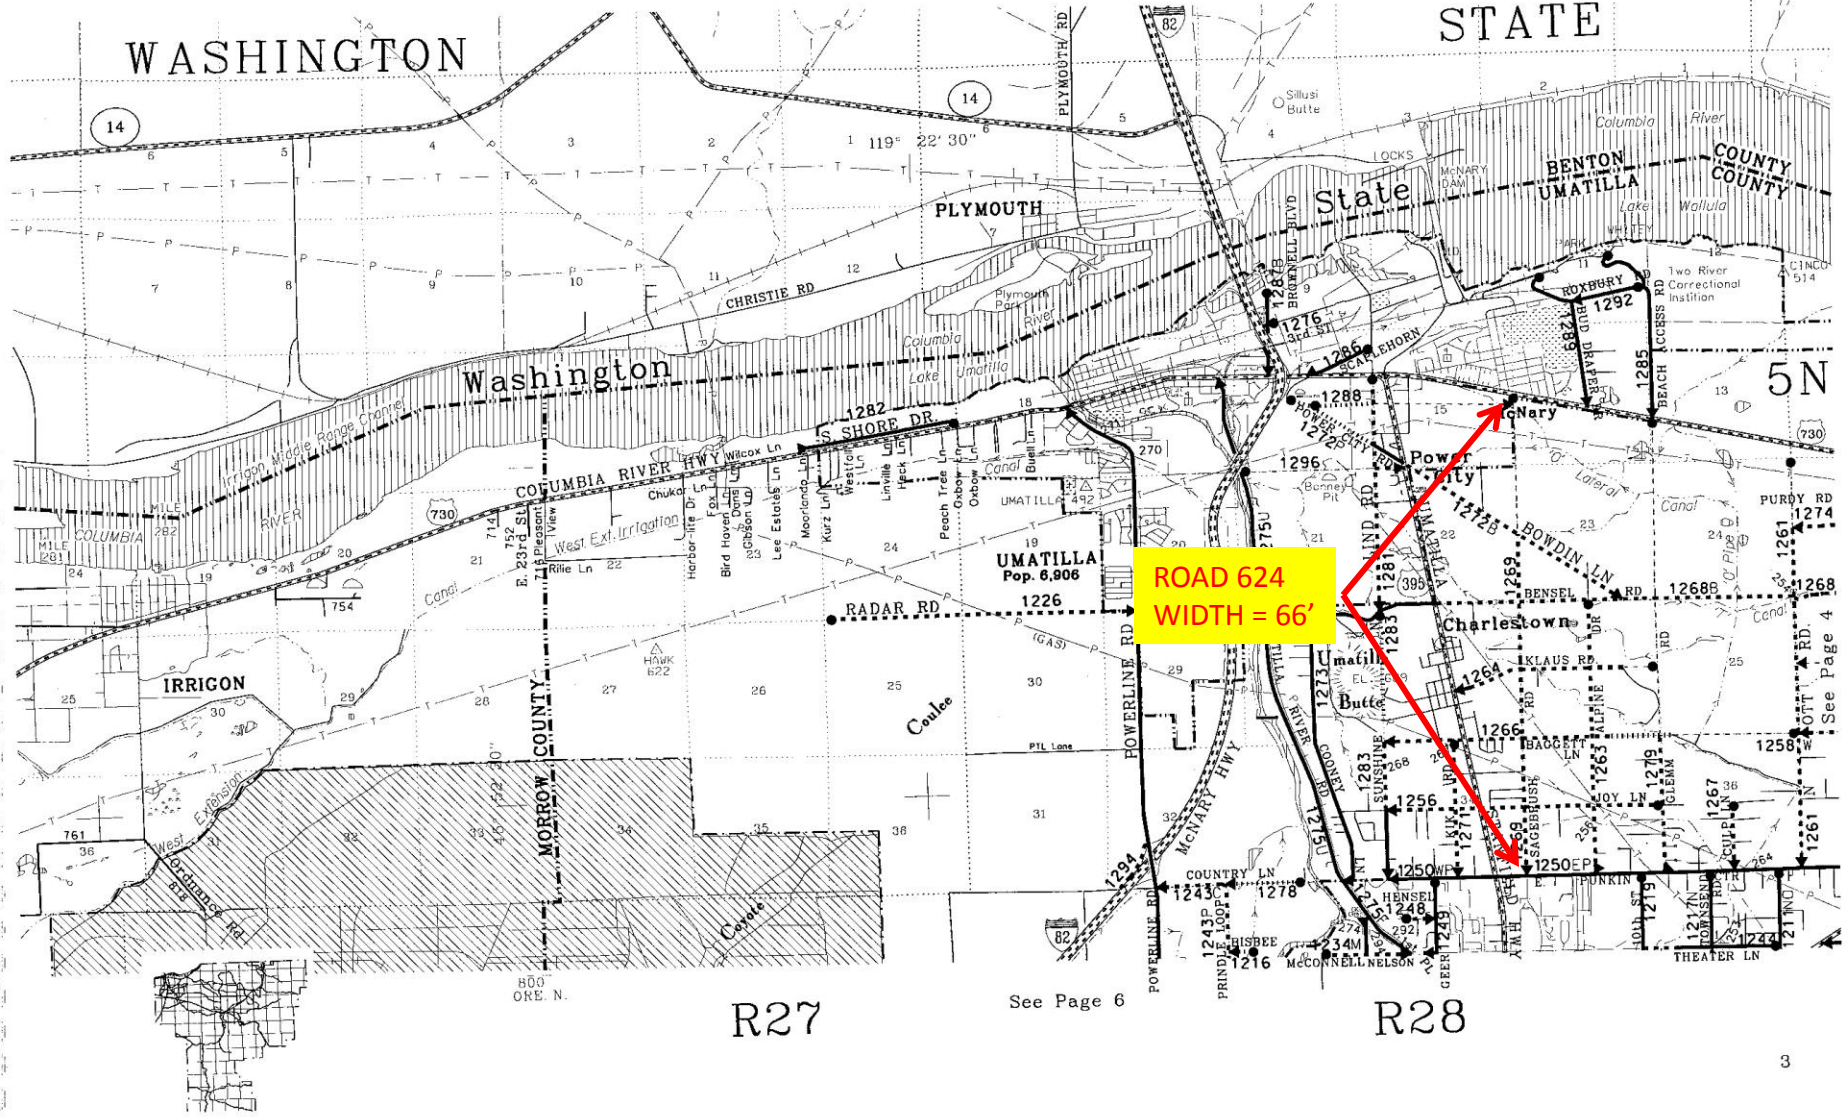

**ROAD 624
WIDTH = 66'**

R27

See Page 6

R28