

PLAN OF ROAD NO.

THIRD ST. EXTENSION.

OUT OF

CITY OF UMATILLA

OREGON.

SCALE 1"=100'

Exhibit "A"



UMATILLA
CITY LIMITS

N 0° 47' W


N 11° 15' E

N 0° 47' W



A

A

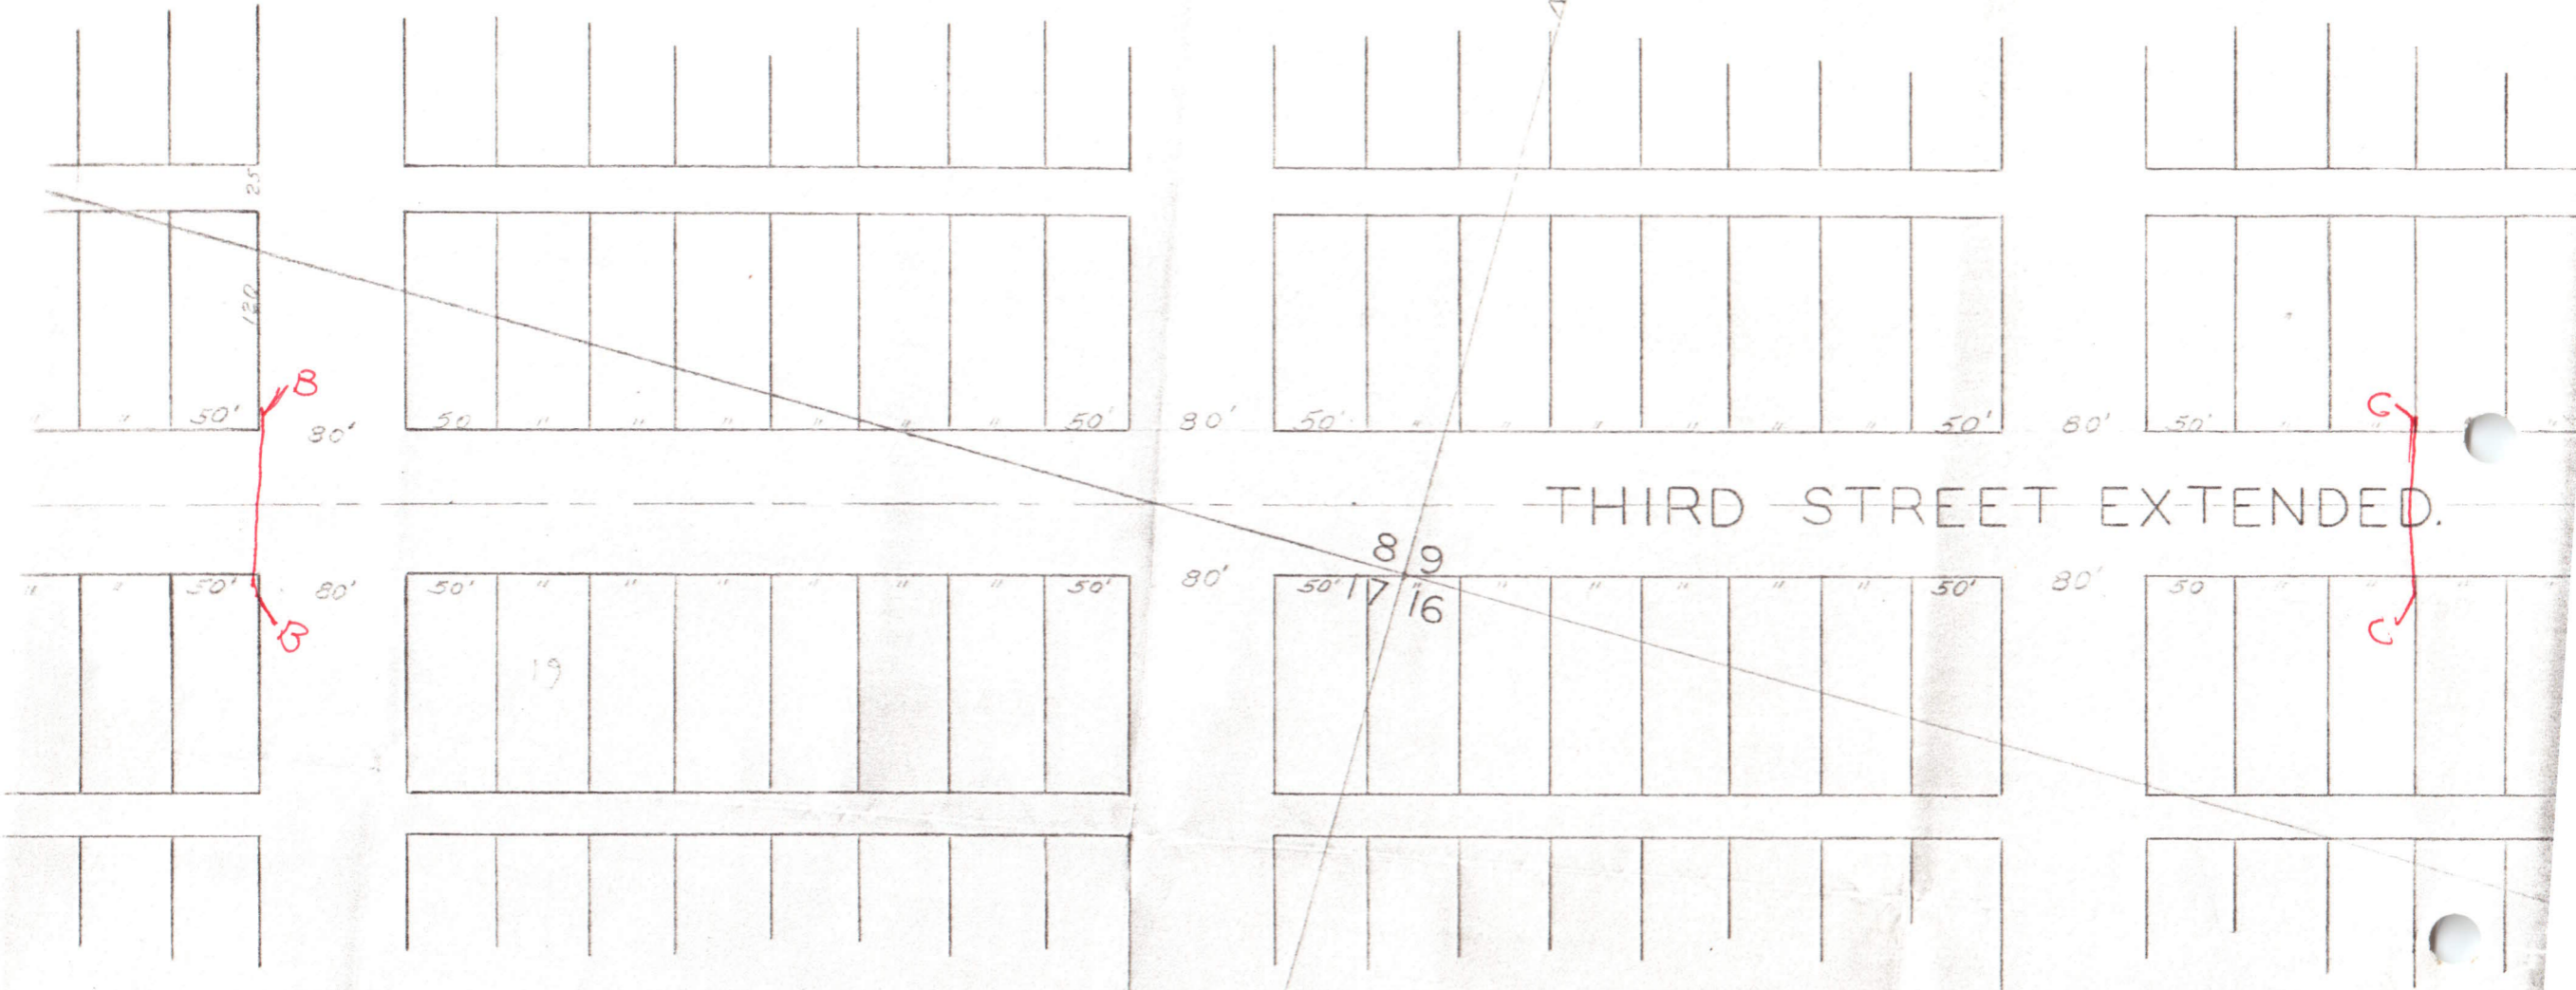

THIRD STREET EXTENDED.

8 9
17 16

19

ENDED.



C
C
D
D

OIL DEPOT ROAD

N 73° 13' E



50'

80'

50'

50'

140.35'

50'





80'

50'

50'

80.308'

80.308'

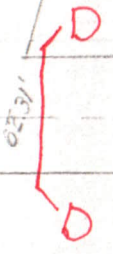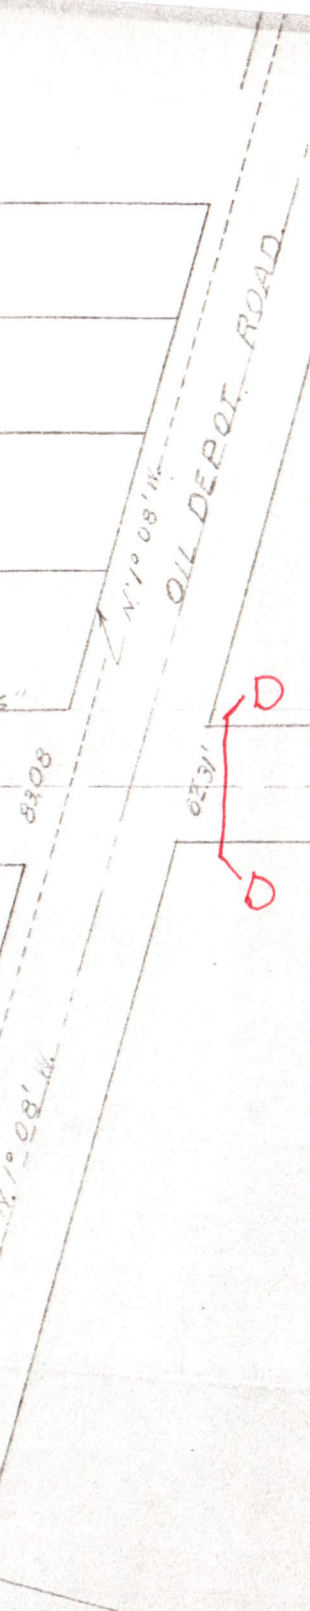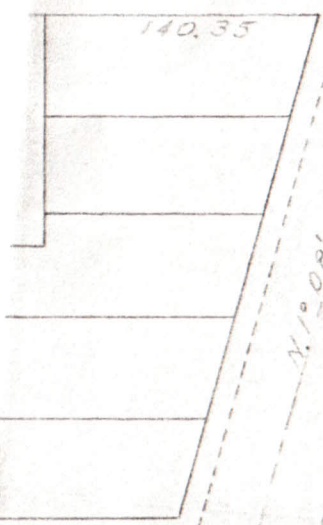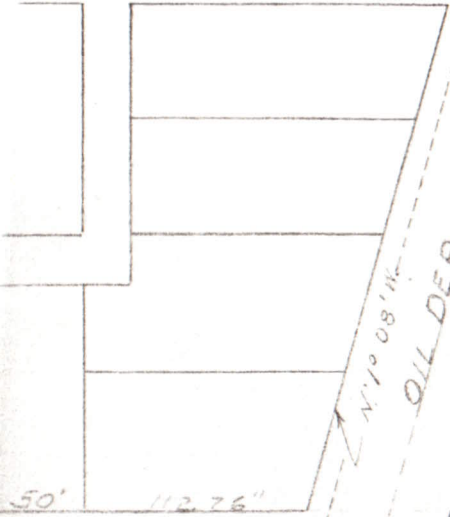

END O

END OF ROAD.

MTG. CO. OF
AMERICA.

9 10
16 15