


WASHINGTON

STATE

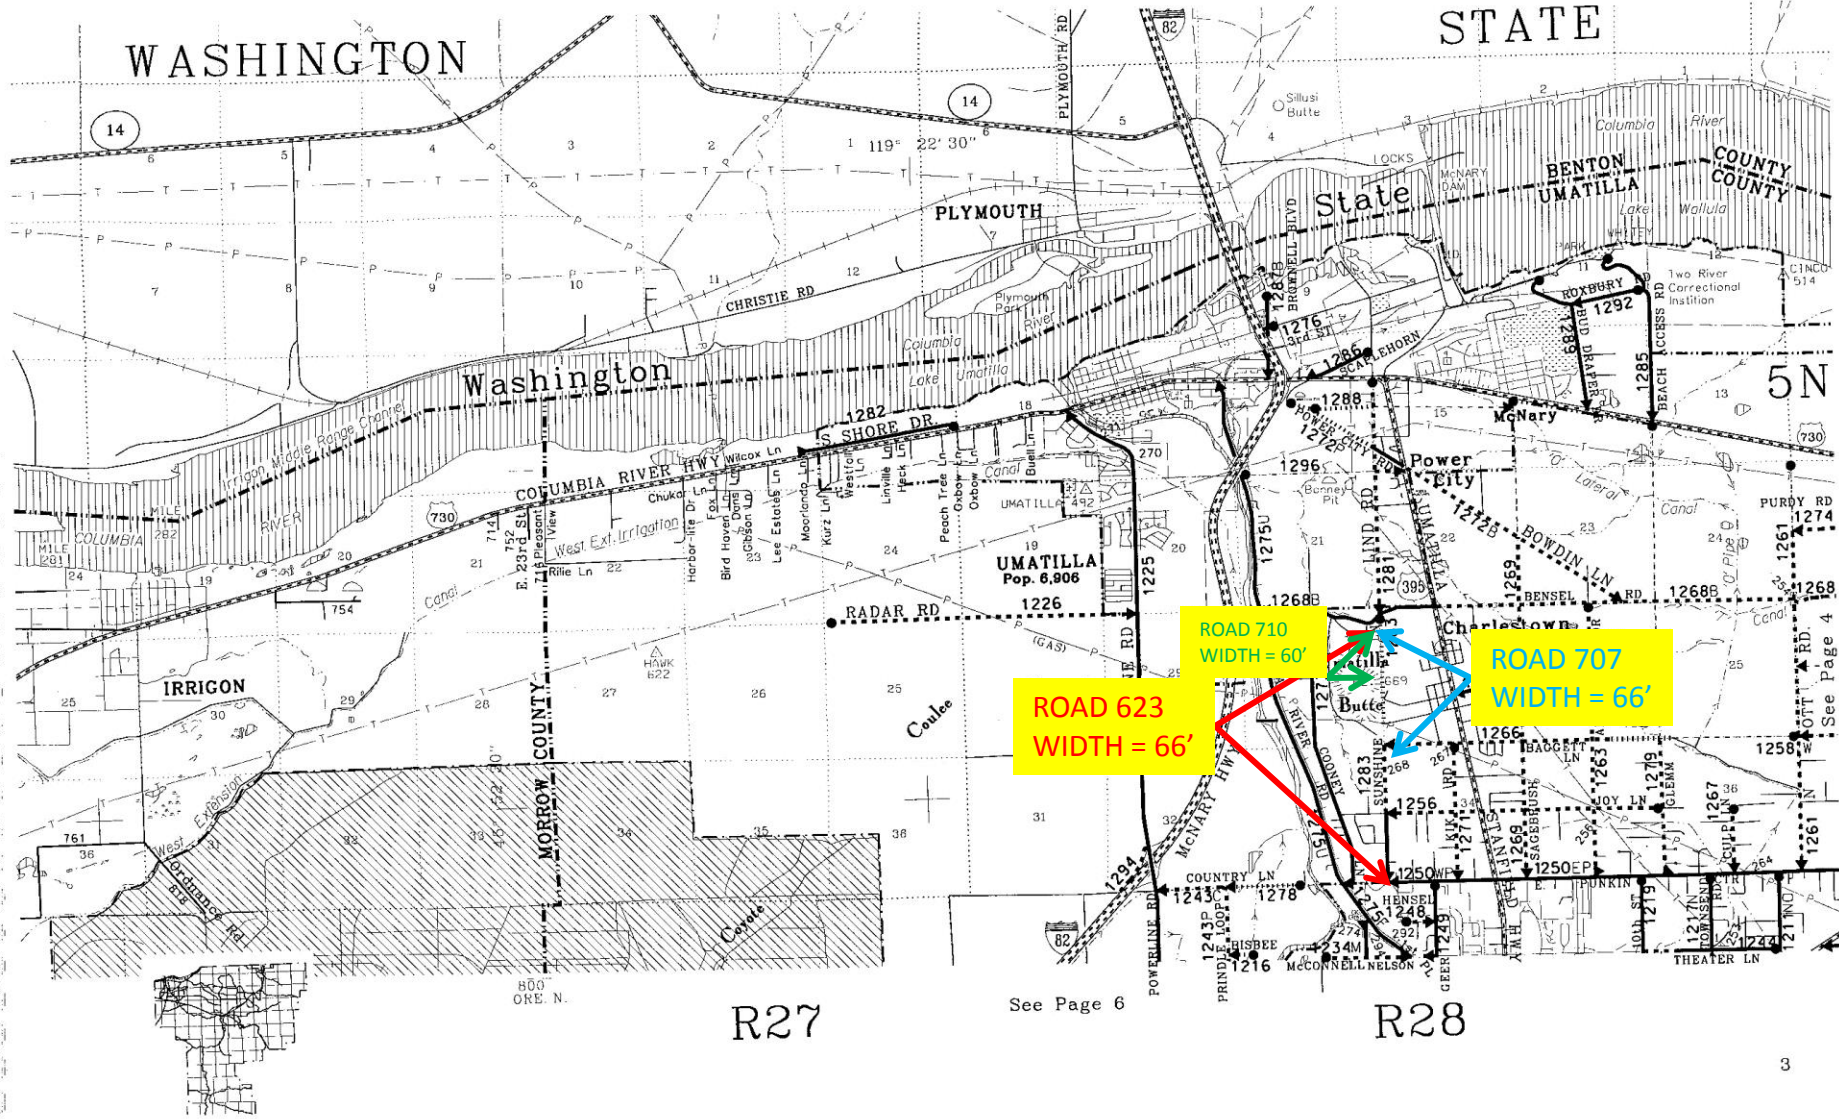

ROAD 710  
WIDTH = 60'

ROAD 707  
WIDTH = 66'

ROAD 623  
WIDTH = 66'

R27

See Page 6

R28