

WASHINGTON

STATE

BENTON
UMATILLA COUNTY
COUNTY

WILDLIFE REFUGE


ROAD 782
WIDTH = 60'

LEGALIZATION 2001
WIDTH = 60'

UMATILLA
Pop. 6,906

See Page 70

69

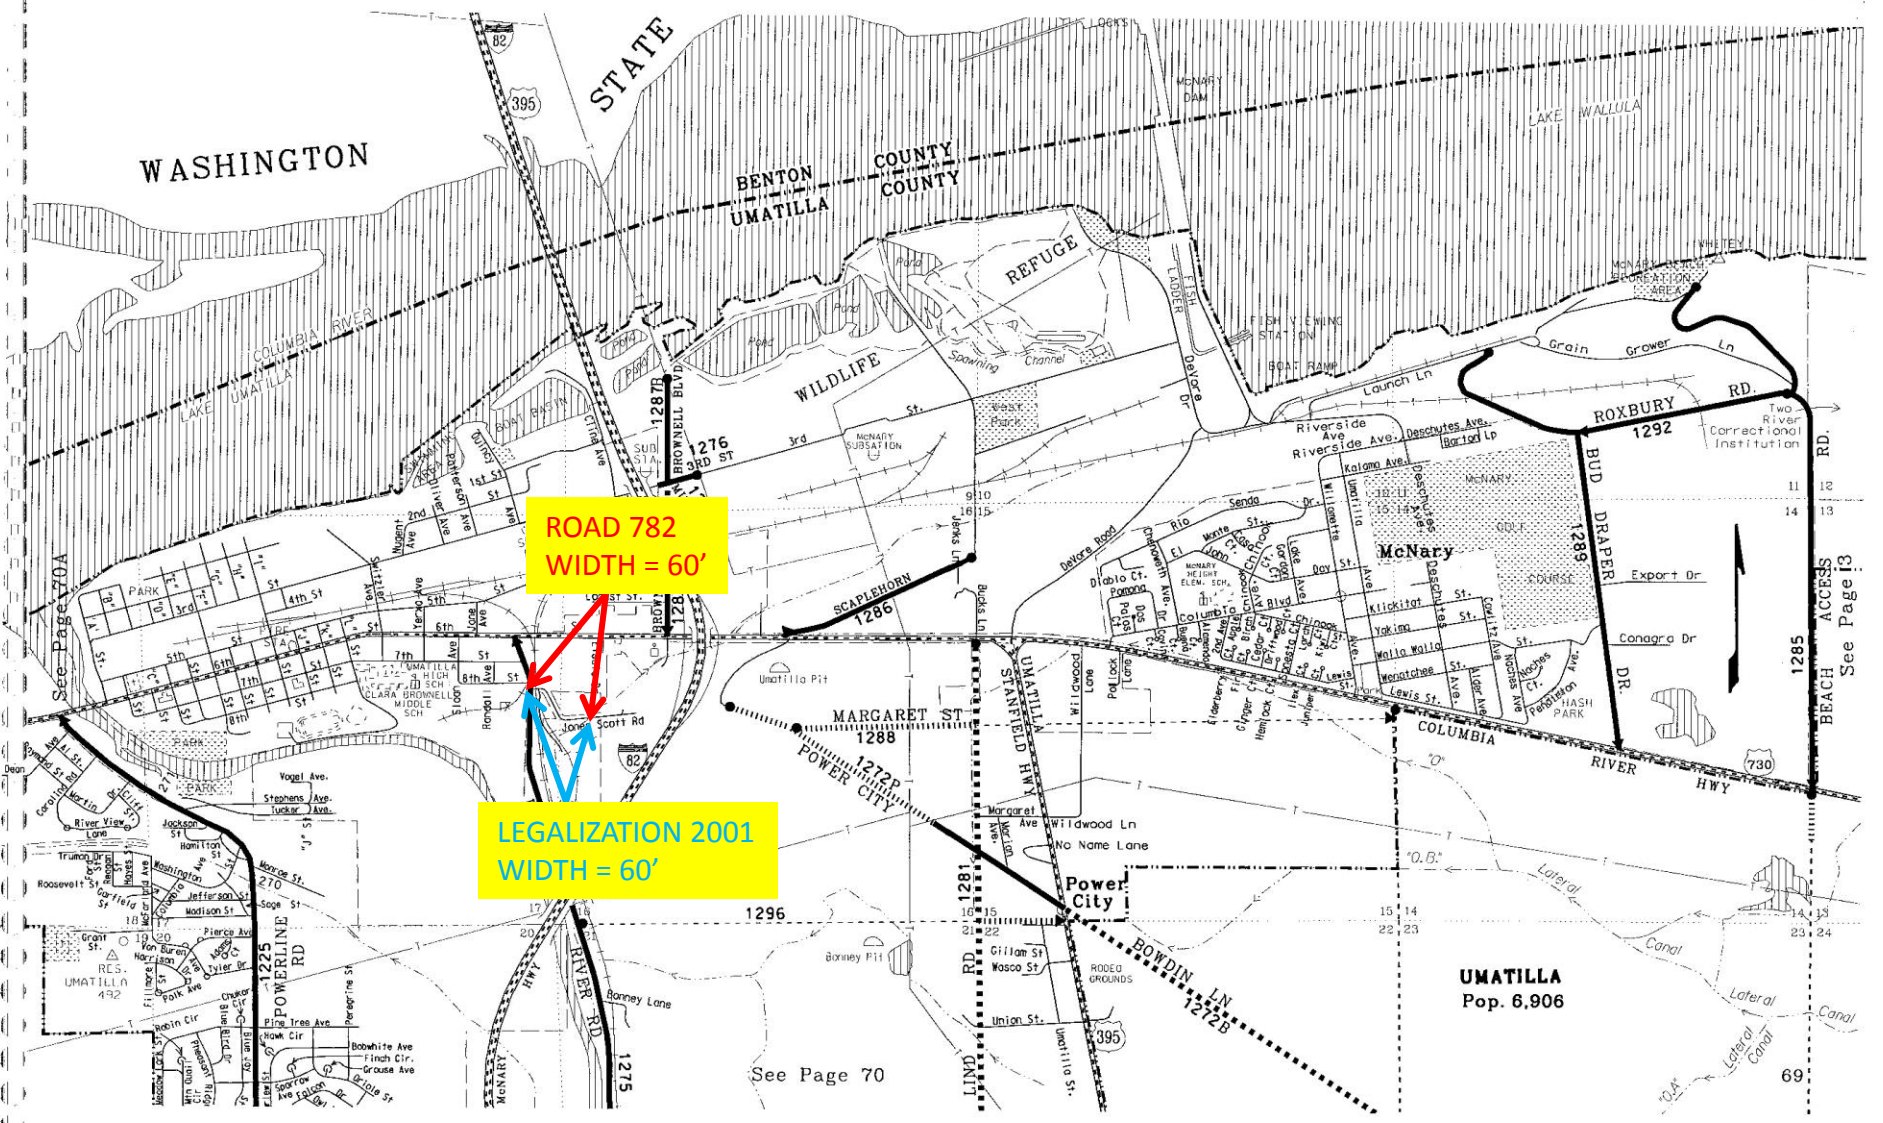

See Page 70A

See Page 13