


WASHINGTON

STATE

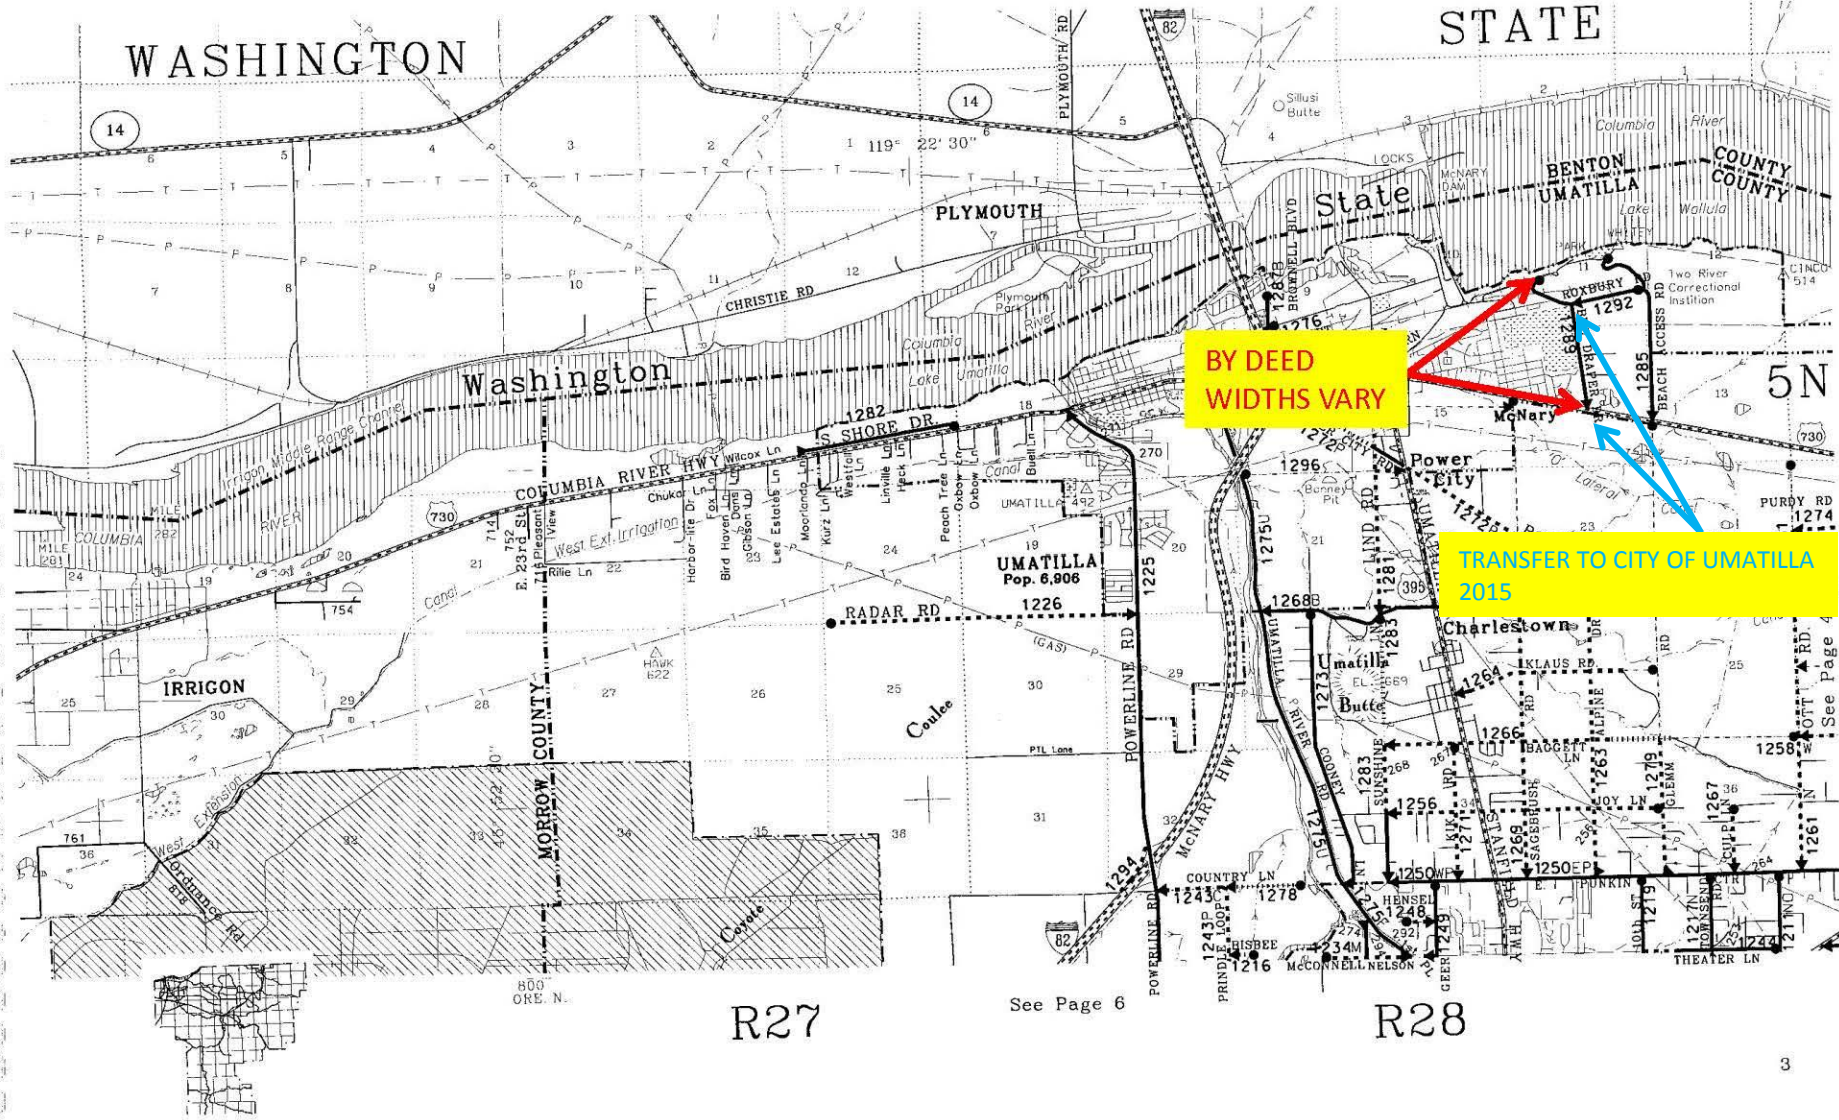

R27

See Page 6

R28