


1585  
1582  
1582

2485A




VICINITY MAP

SCALE 1"=400'

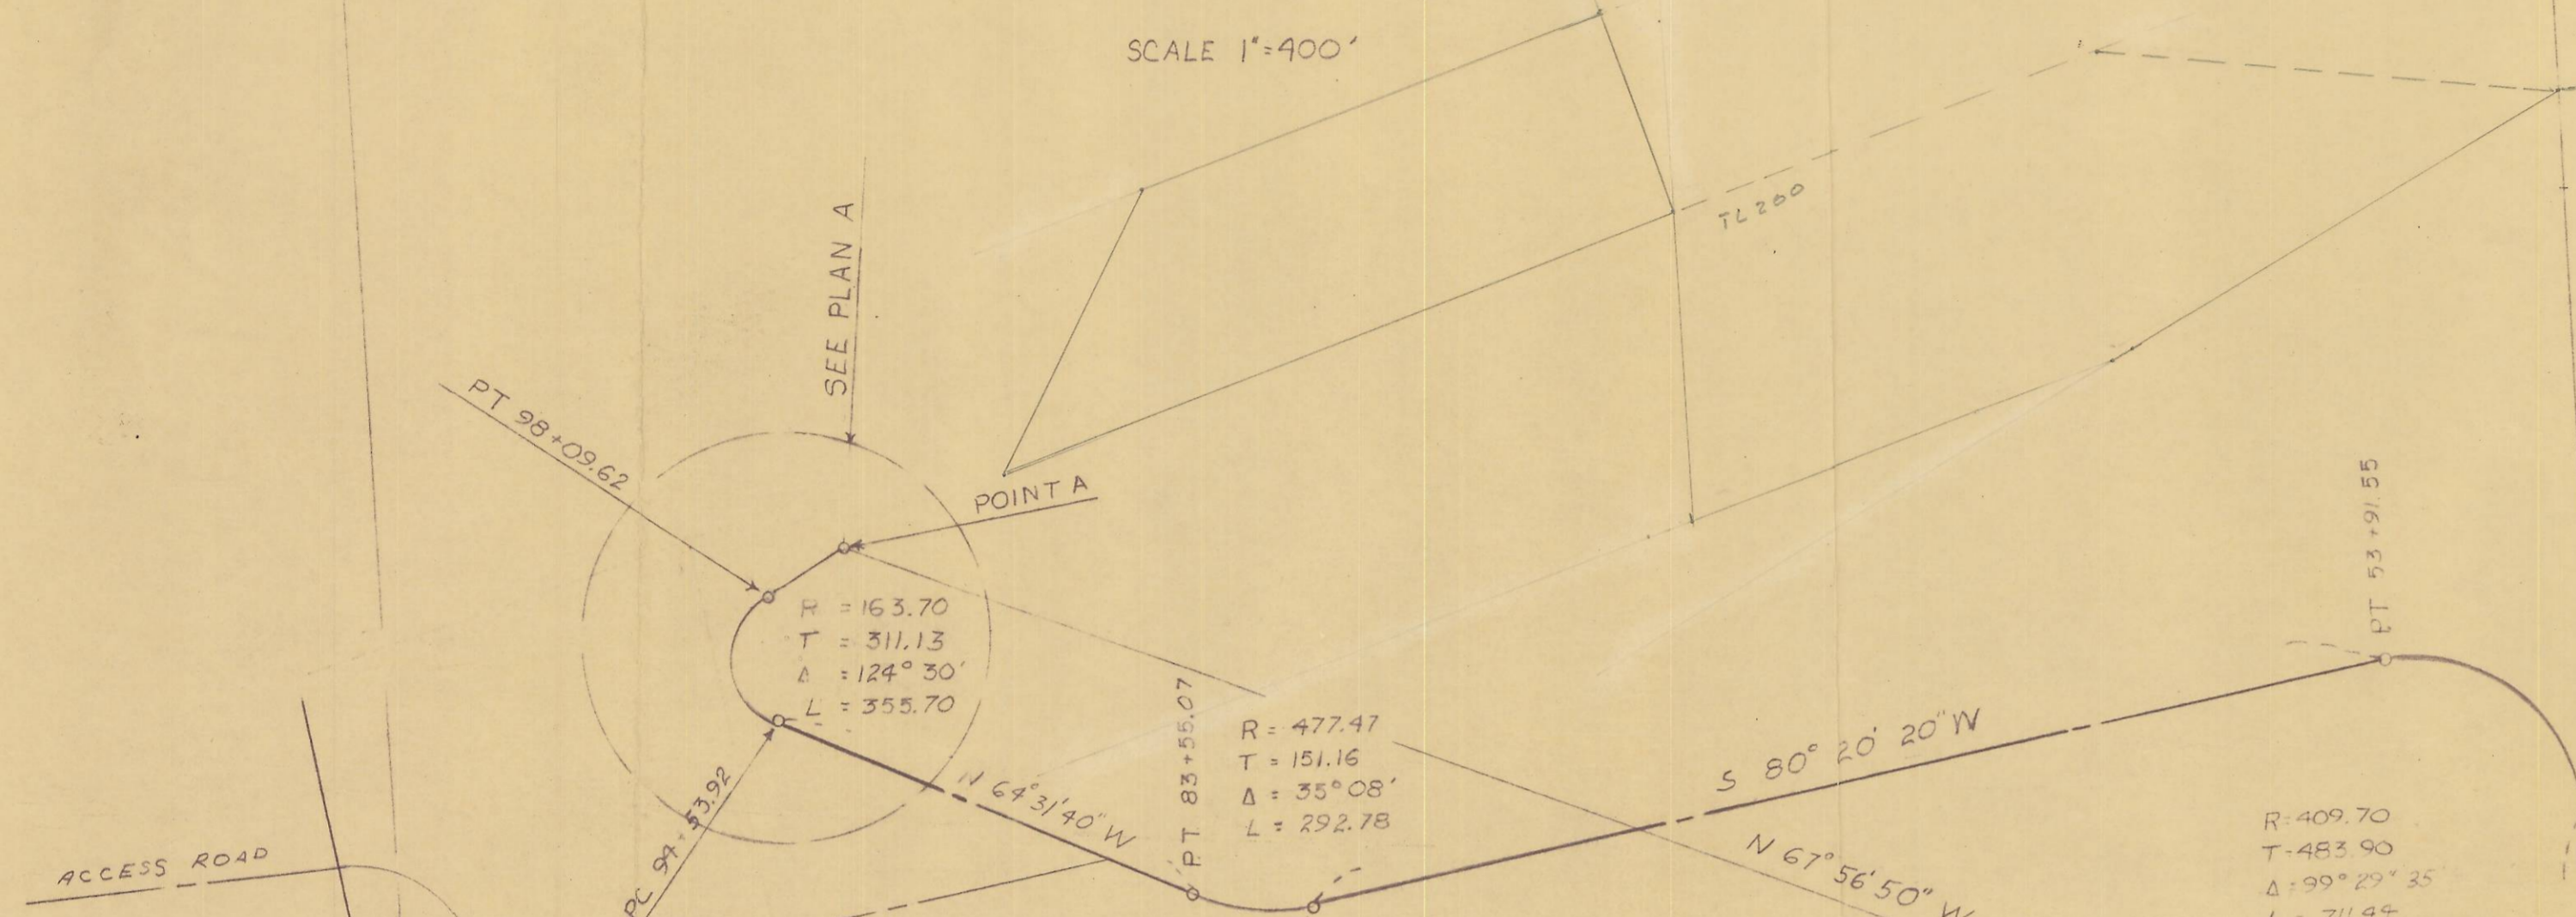

PLAN A

SCALE 1"=100'

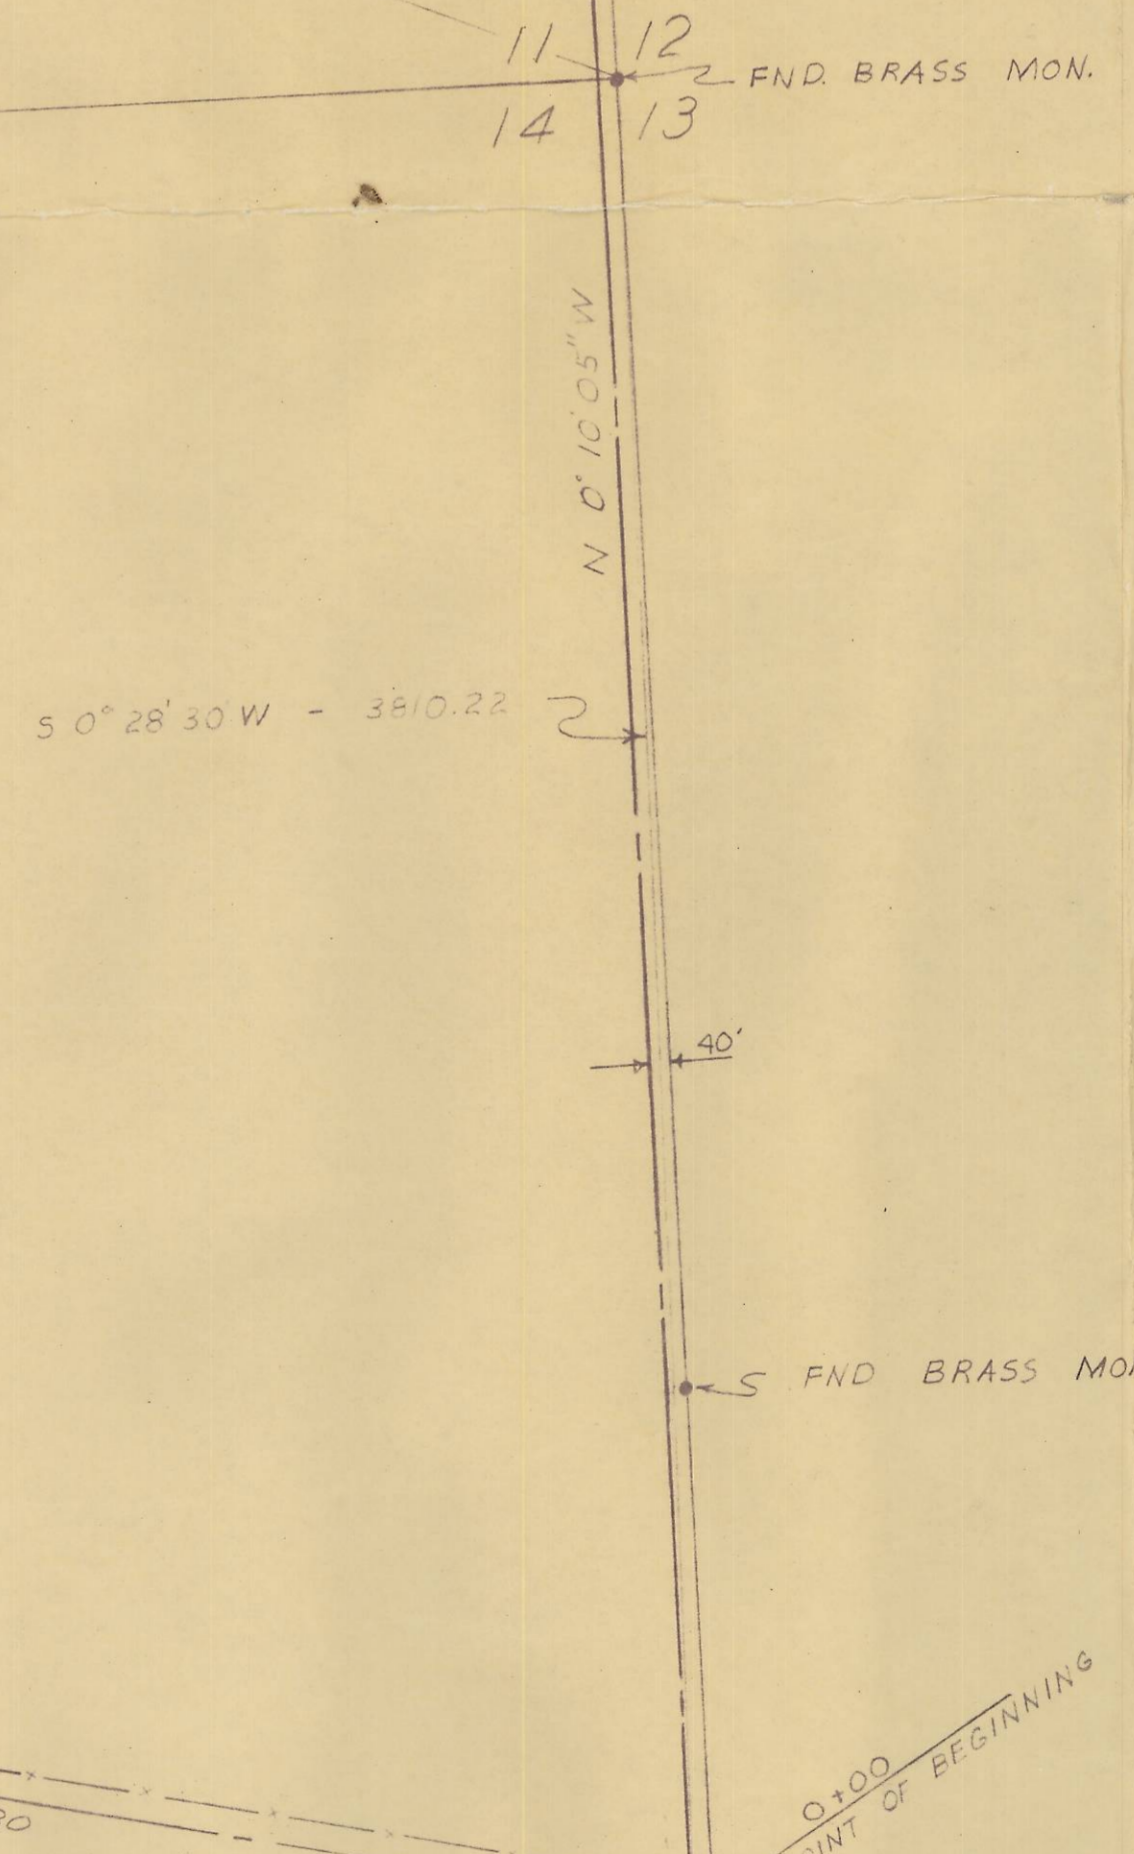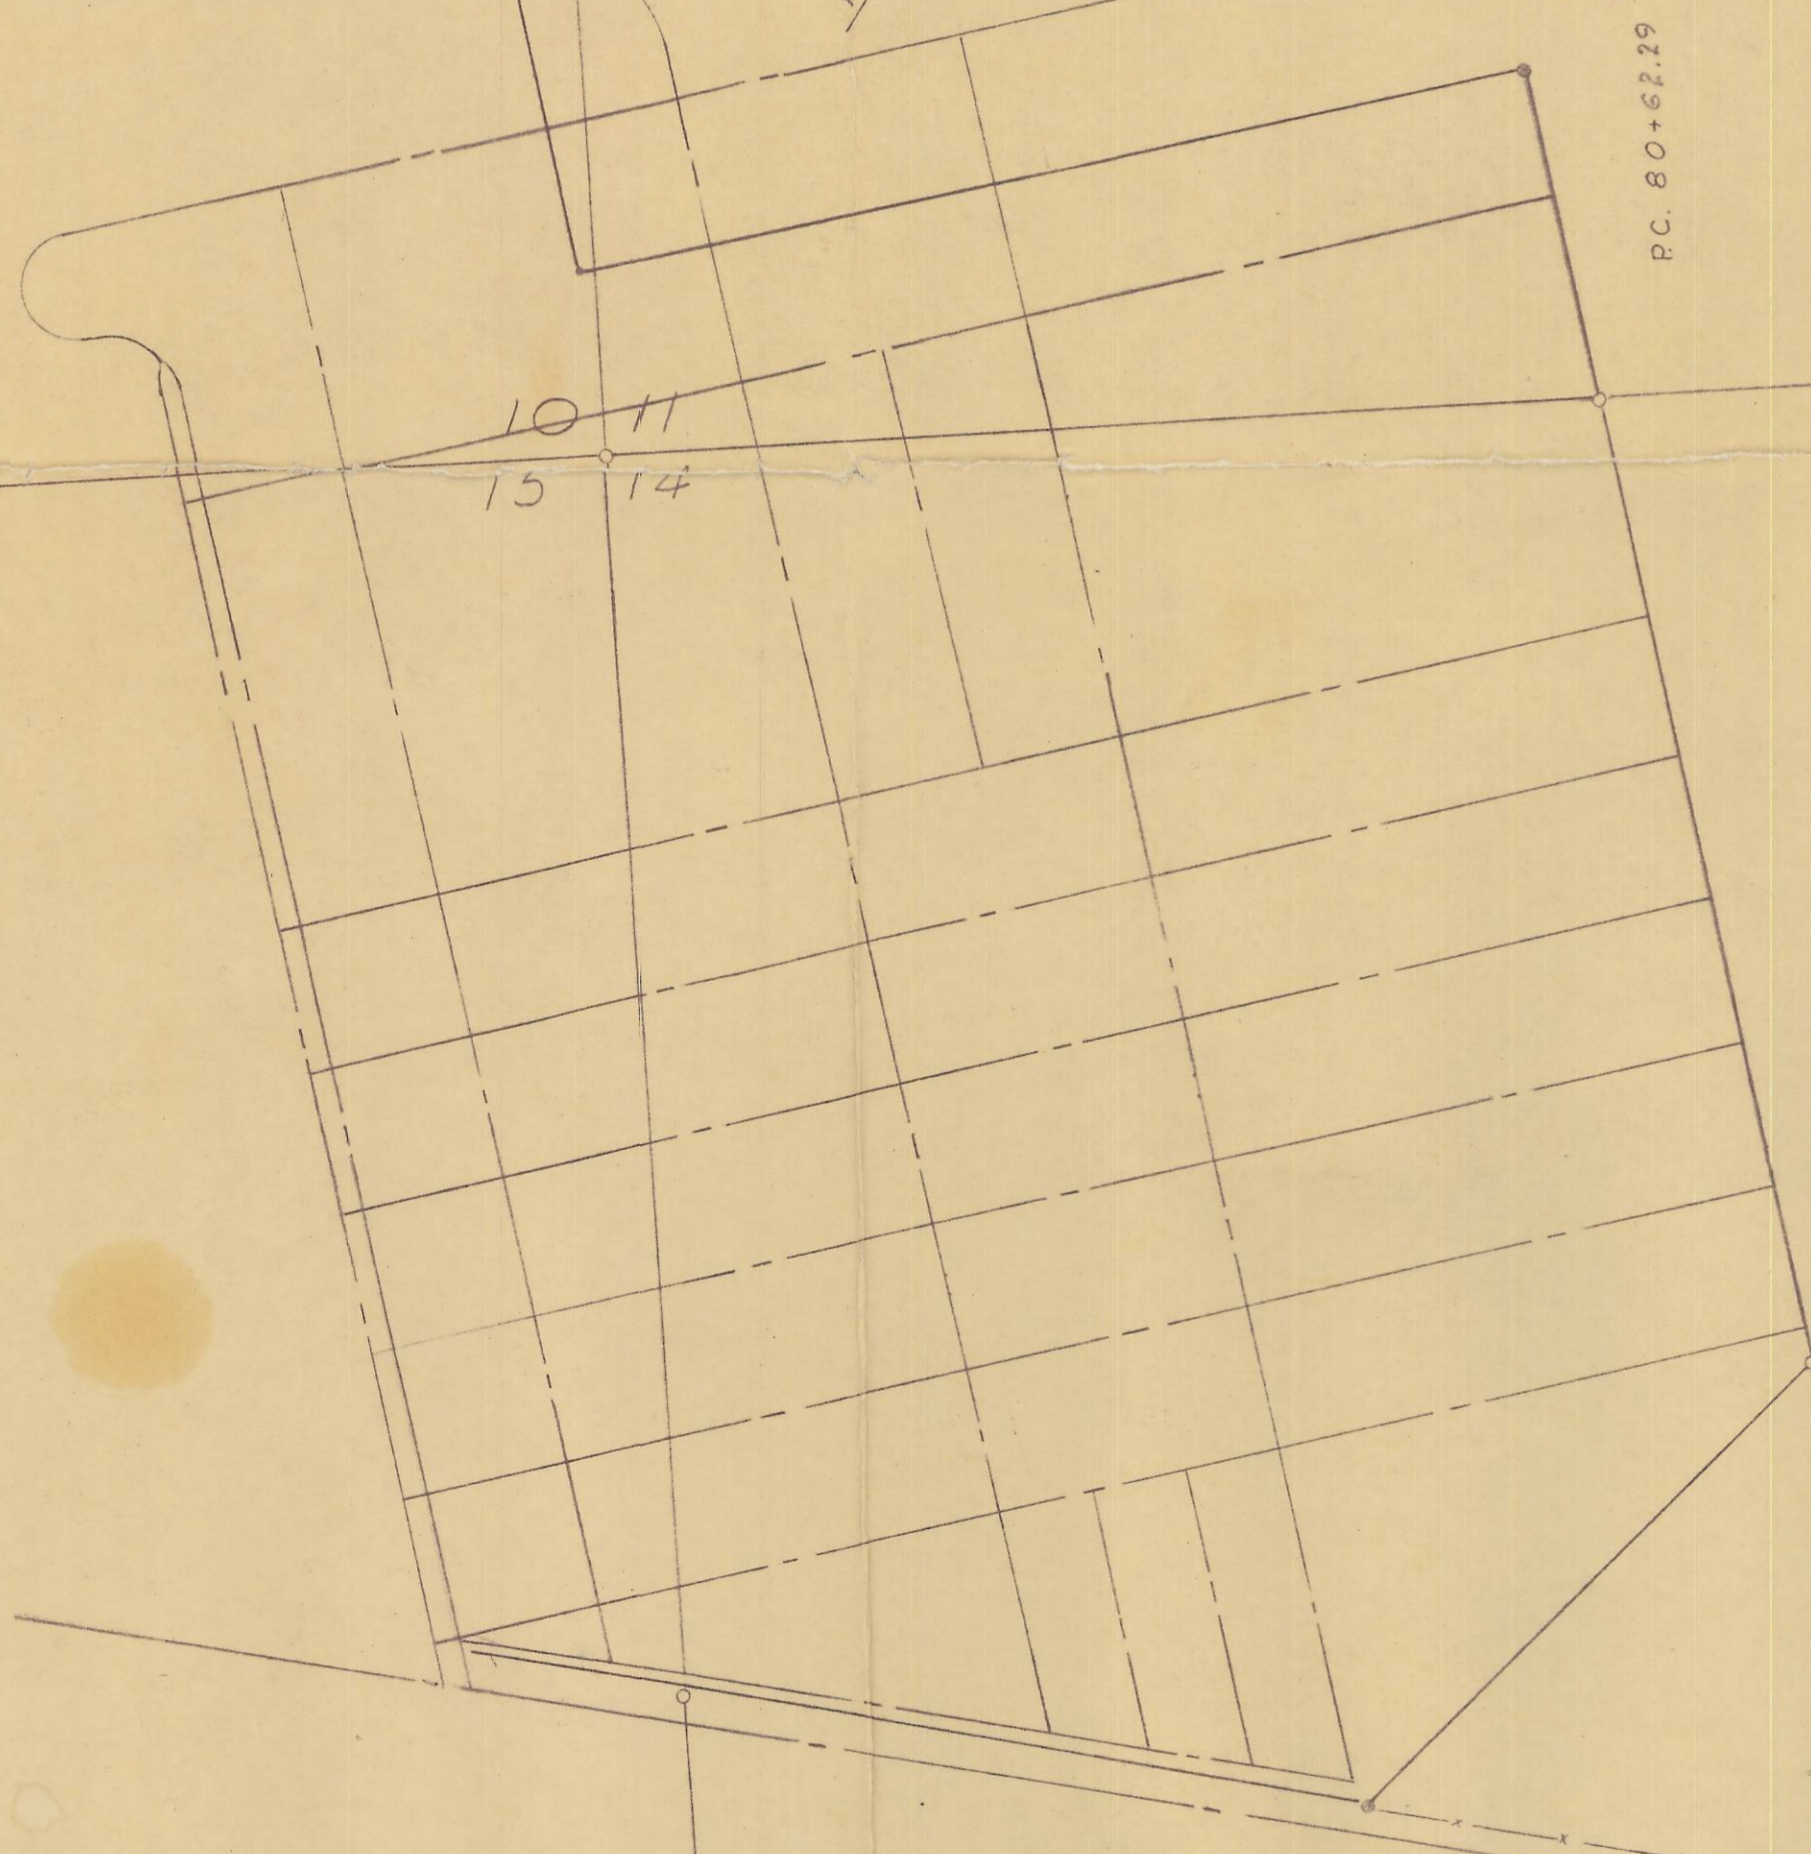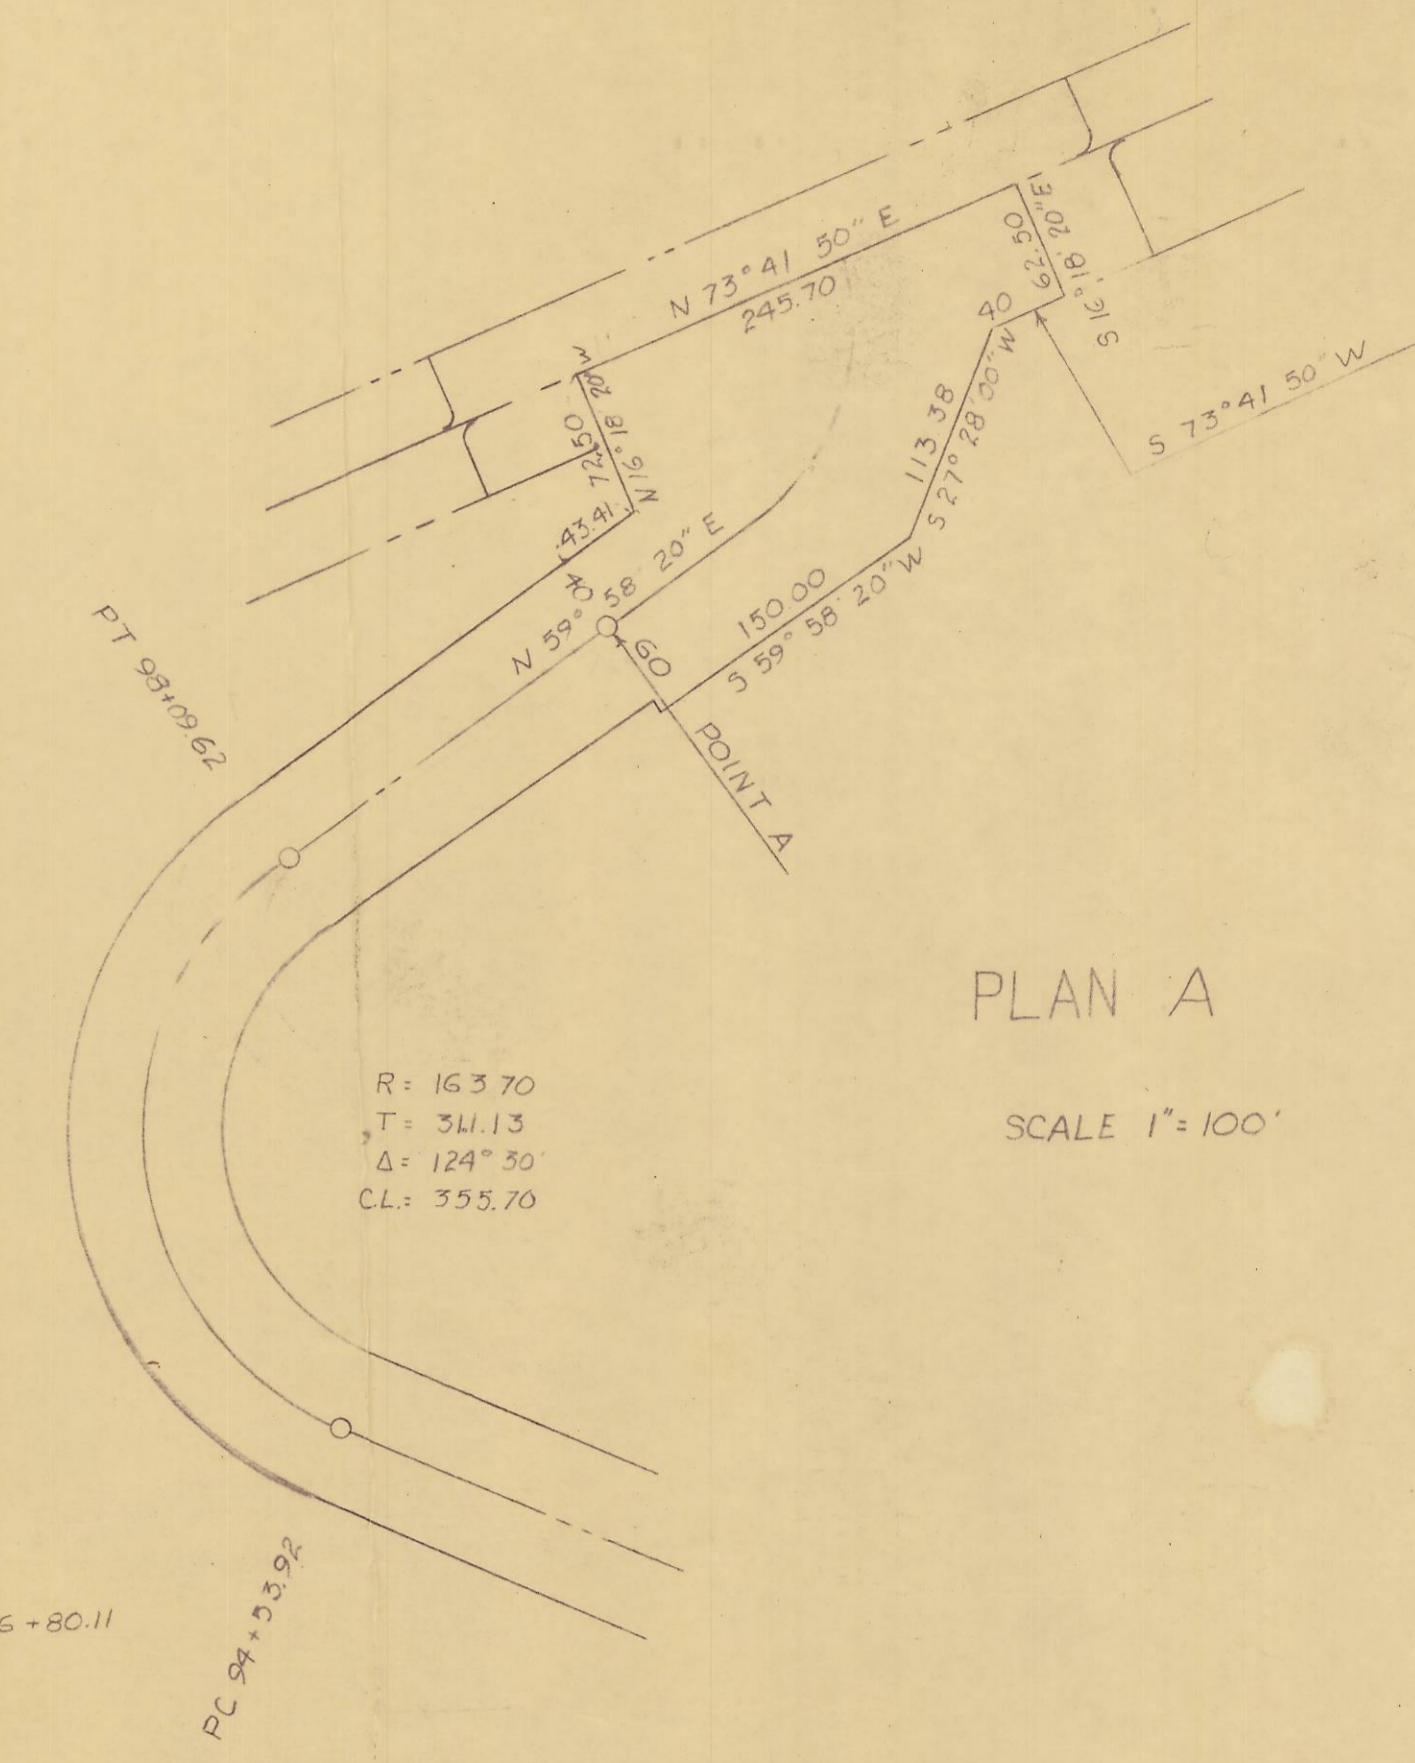

NOTE:  
BEARINGS ARE BASED UPON TIES TO NOS STATIONS "CINCO", "VACA", AND "WHITEY". THOSE SHOWN ARE TRUE. θ = +0° 51' 25"  
SEA LEVEL GRID FACTOR = 9999560

REGISTERED PROFESSIONAL SURVEYOR  
David H. Kumbien  
DATE: 12/1/72

WAYNE HARRIS CO., INC.  
SURVEY FOR  
COUNTY ROAD DEPARTMENT  
PORT OF UMATILLA ROAD  
SEC. 11 & 14, T5N, R28E, W.M.

SCALE	DATE	DRN BY	DRNG NO
A3 SHOWN	12/1/72	TH	72-318-G