STA. 120 TO STA. 285
(HIGHWAY ENDS @ STA. 242)

NORTH UNIT— PART II
OF TWO PARTS

OREGON STATE HIGHWAY DEPARTMENT

LOCATED "L" LINE

PENDLETON-PILOT ROCK SECTION

PENDLETON - JOHN DAY HIGHWAY

Umatilla County

Scale: 1" = 100'

Oregon Coordinate System

J.T. Burch, Resident Engr. - 1958

"AS CONSTRUCTED" DATA IN RED
STA 200+00 N. TO STA. 161+82.06 N. EQUATION. &
STA. 0+00 TO STA. 242+00
CONTRACT NO. 4781 — NOV. 14, 1956 to OCT. 28, 1957
J. H. WALKER, RESIDENT ENGR.

7F 2-8
SH. 1

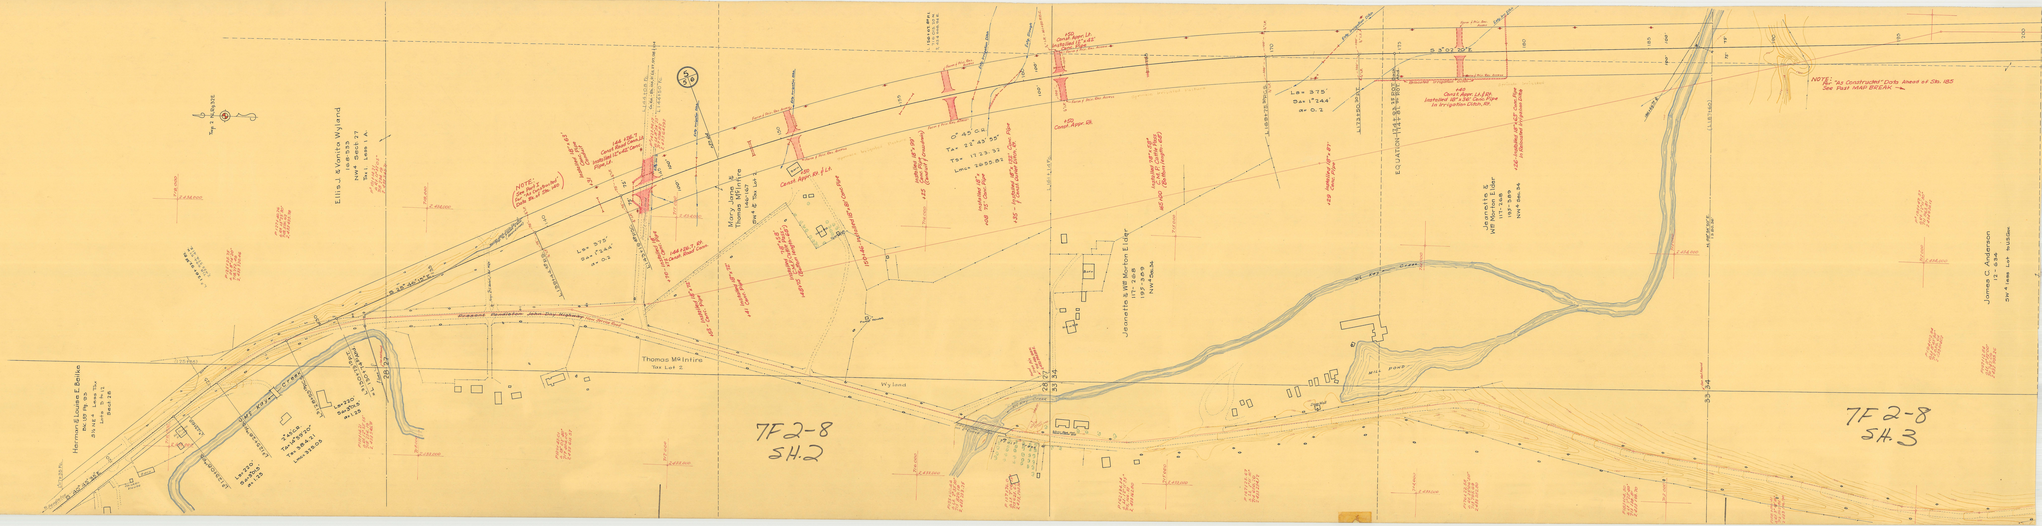
Ellis J. & Vonita Wyland
Mary Jane & Thomas McIntire
Thomas McIntire
Jeanette & Will Morton Elder
Jeanette & Will Morton Elder
Herman & Louise E. Bailey
James C. Anderson
Wyland
Wyland
Umatilla River
Old Pendleton - John Day Highway
Old Pendleton - John Day Highway
Top of Rock
Grade Appr. 6%
Grade Appr. 6% Installed 48" x 36" Conc. Pipe in Irrigation Canal, Rt.