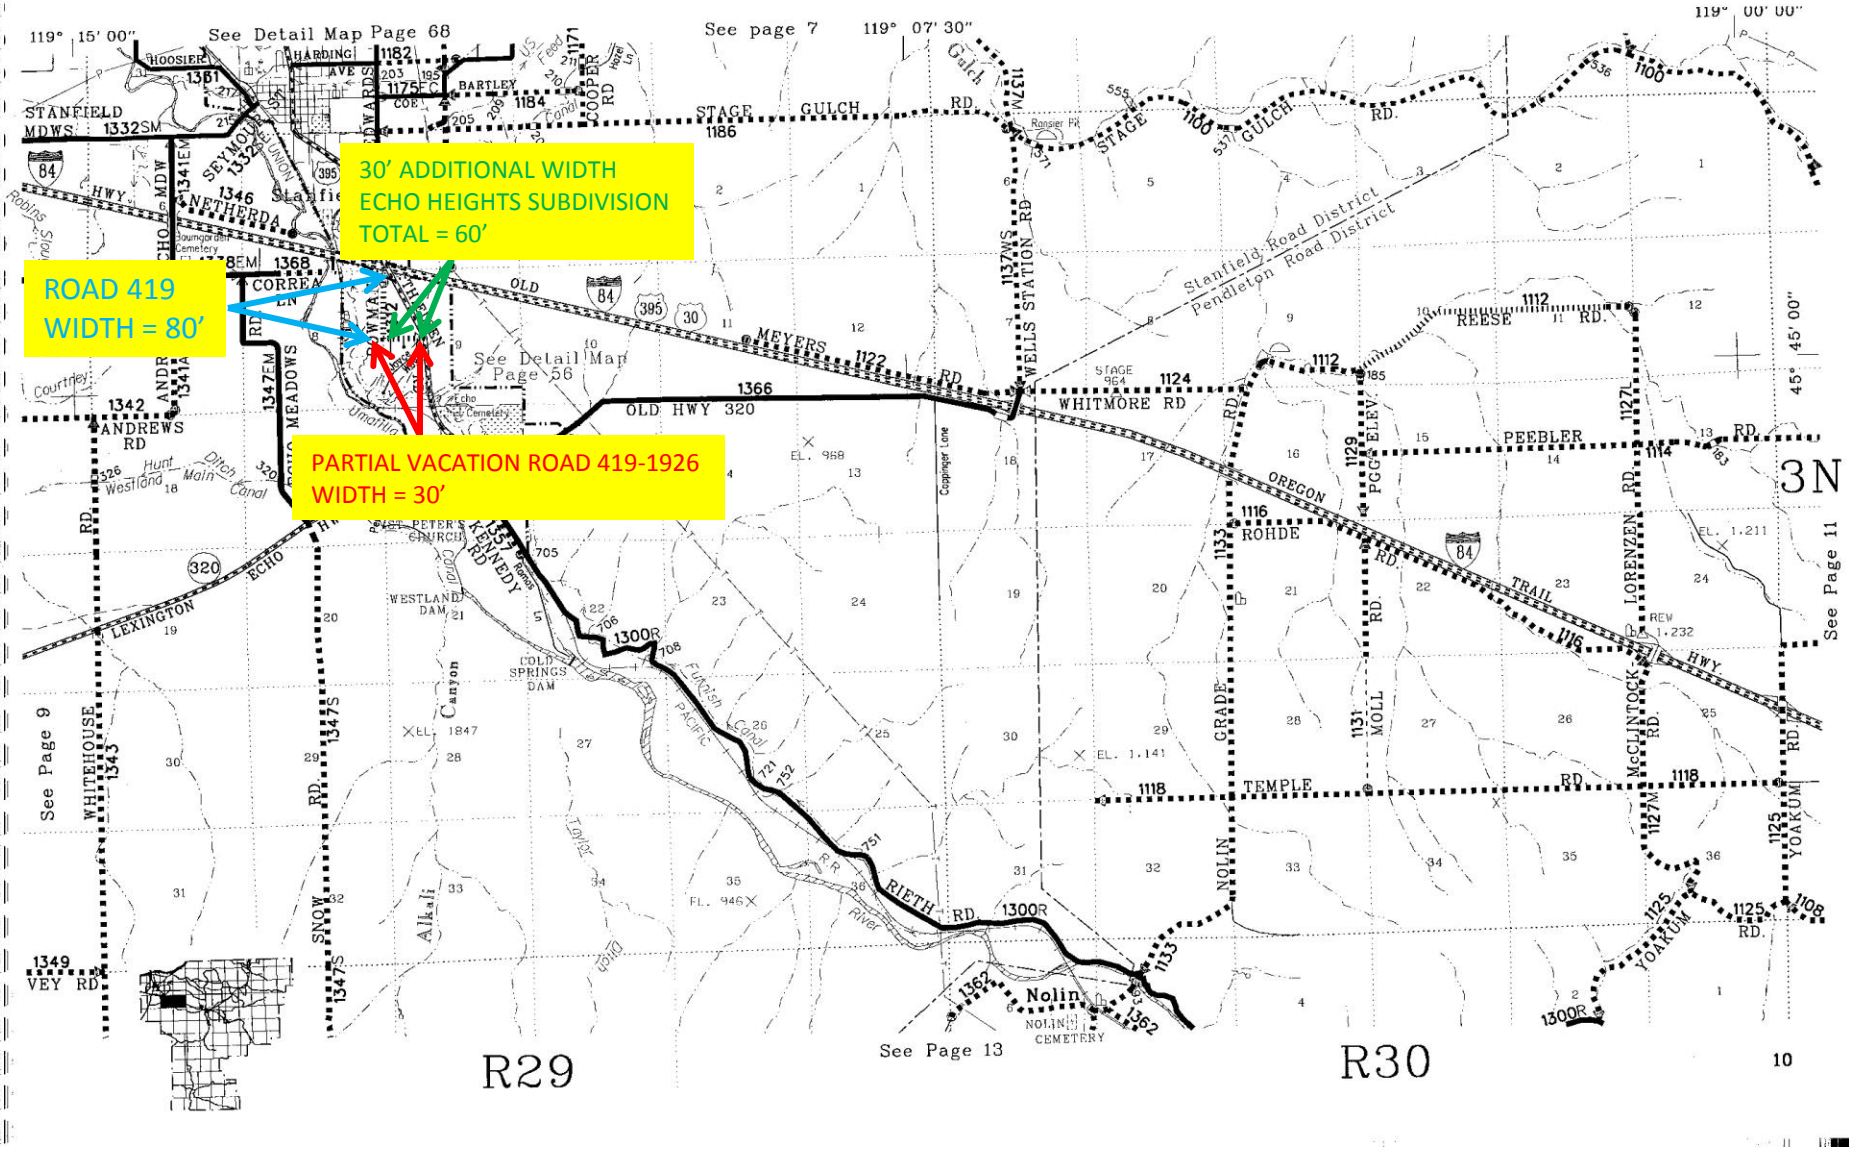
30' ADDITIONAL WIDTH
ECHO HEIGHTS SUBDIVISION
TOTAL = 60'
ROAD 419
WIDTH = 80'
PARTIAL VACATION ROAD 419-1926
WIDTH = 30'
See Detail Map Page 68
See page 7
See Detail Map Page 56
See Page 9
See Page 11
See Page 13
119° 15' 00"
119° 07' 30"
119° 00' 00"
45° 00'
3N
R29
R30
STANFIELD MDWS.
STAGE GULCH RD.
WELLS STATION RD
MEYERS RD
OLD HWY 320
WHITMORE RD
REESE RD.
PEEBLER RD.
OREGON TRAIL HWY
ROHDE
GRADE
TEMPLE RD
NOLIN
RIETH RD
McCLINTOCK RD.
YOAKUM RD.
LORENZEN RD.
ANDREWS RD
MEADOWS
KENNEDY RD
LEXINGTON
ECHO
WHITEHOUSE
SNOW
VEY RD
Stanfield Road District
Pendleton Road District
Nolin
NOLIN CEMETERY
WESTLAND DAM
COLD SPRINGS DAM
Alkali Canyon
Umatilla River
Westland Main Canal
Furnish Canal
Taylor Ditch
Coppinger Lane
Courtney
Robinson
1366
1300R
1122
1124
1112
1116
1118
1125
1127L
1127M
1129
1131
1133
1137WS
1186
1349
1342
1347EM
1347S
1343
1362
1368
1332SM
1346
1182
1184
1175
1171
1100
1108
EL. 968
EL. 1.211
EL. 1.232
EL. 1847
EL. 1.141
EL. 946
10