


Plat of Road No 492

492

T 4 N R 29 E W 1/4

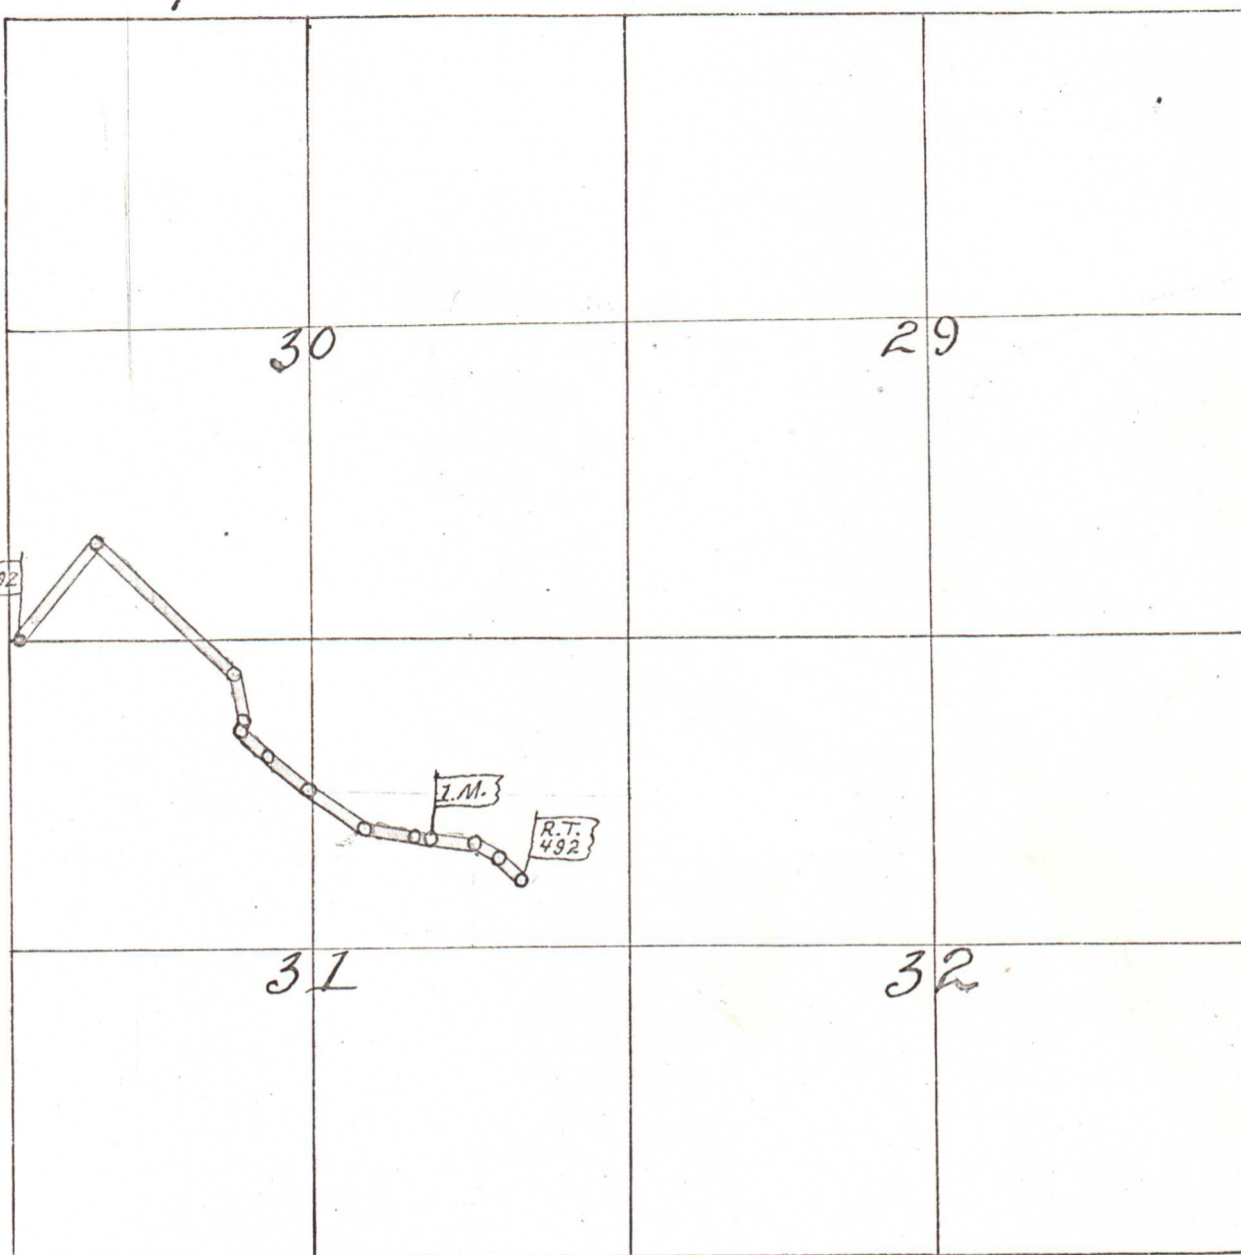

I here by certify that the above is a true Plat of Road No 492
 as surveyed by me Feb. 21st 1898
 John W. White County Surveyor

 11/24/11

NOW, the condition of the above obligation is such, That, whereas the above named C. C. Hunt

and

and others,

have petitioned the County Court of said County of Unadilla, at the January
 Term, 1898, thereof, for a County Road, commencing at a point on the present County
 Road 11⁵⁰ chains East of the NW cor Sec 31 in T 4 N. R. 29
 E. W. M. thence running Southeastly crossing the Rail
 Road and intersecting the present County Road in the
 E² NW⁴ Sec 31 T 4 N. R. 29 E. W. M. and to vacate the
 present county Road intervening between the point of commencing and
 ending of the above proposed Road

NOW, if the above named C. C. Hunt