


SEE US 30 JCT TO MEADOWS JCT PLANS

FROM STATE WIDTH VARIES

ROAD 172 WIDTH = 60'

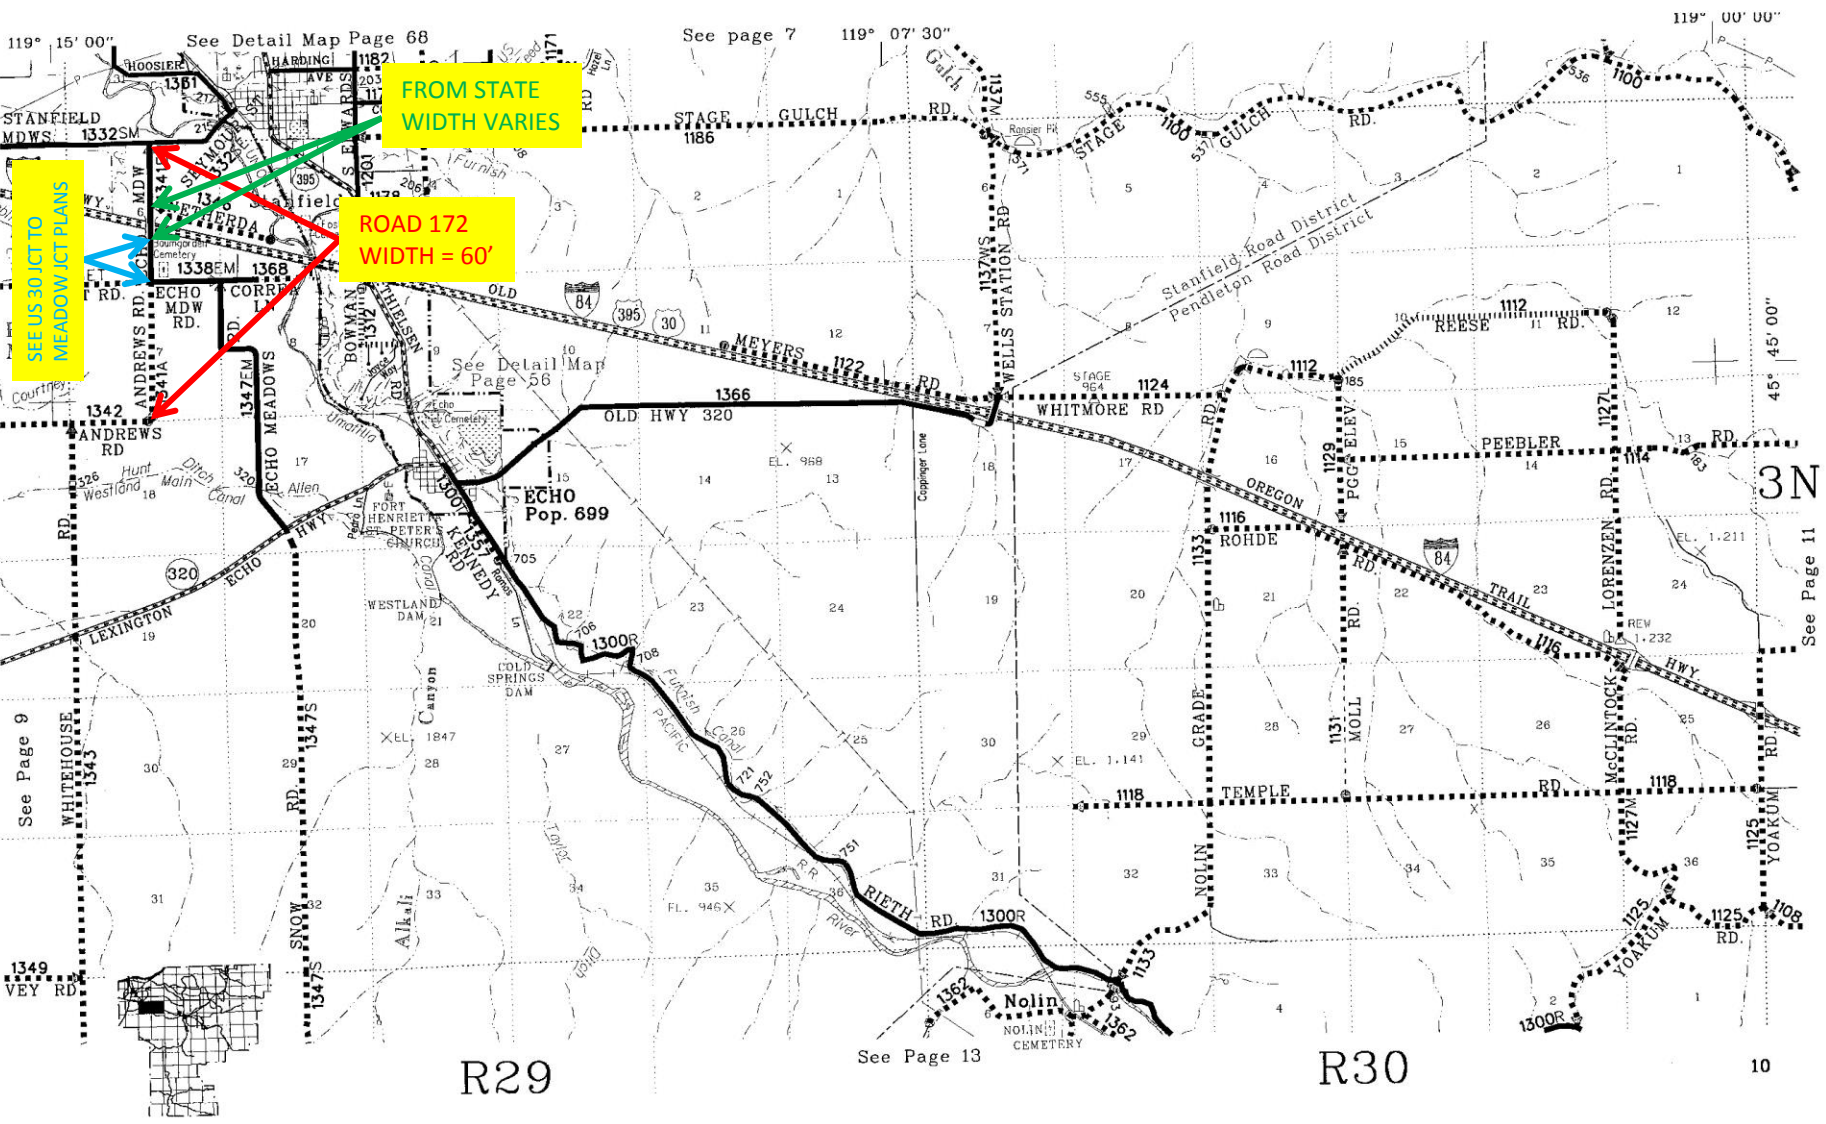

R29

See Page 13

R30

10

