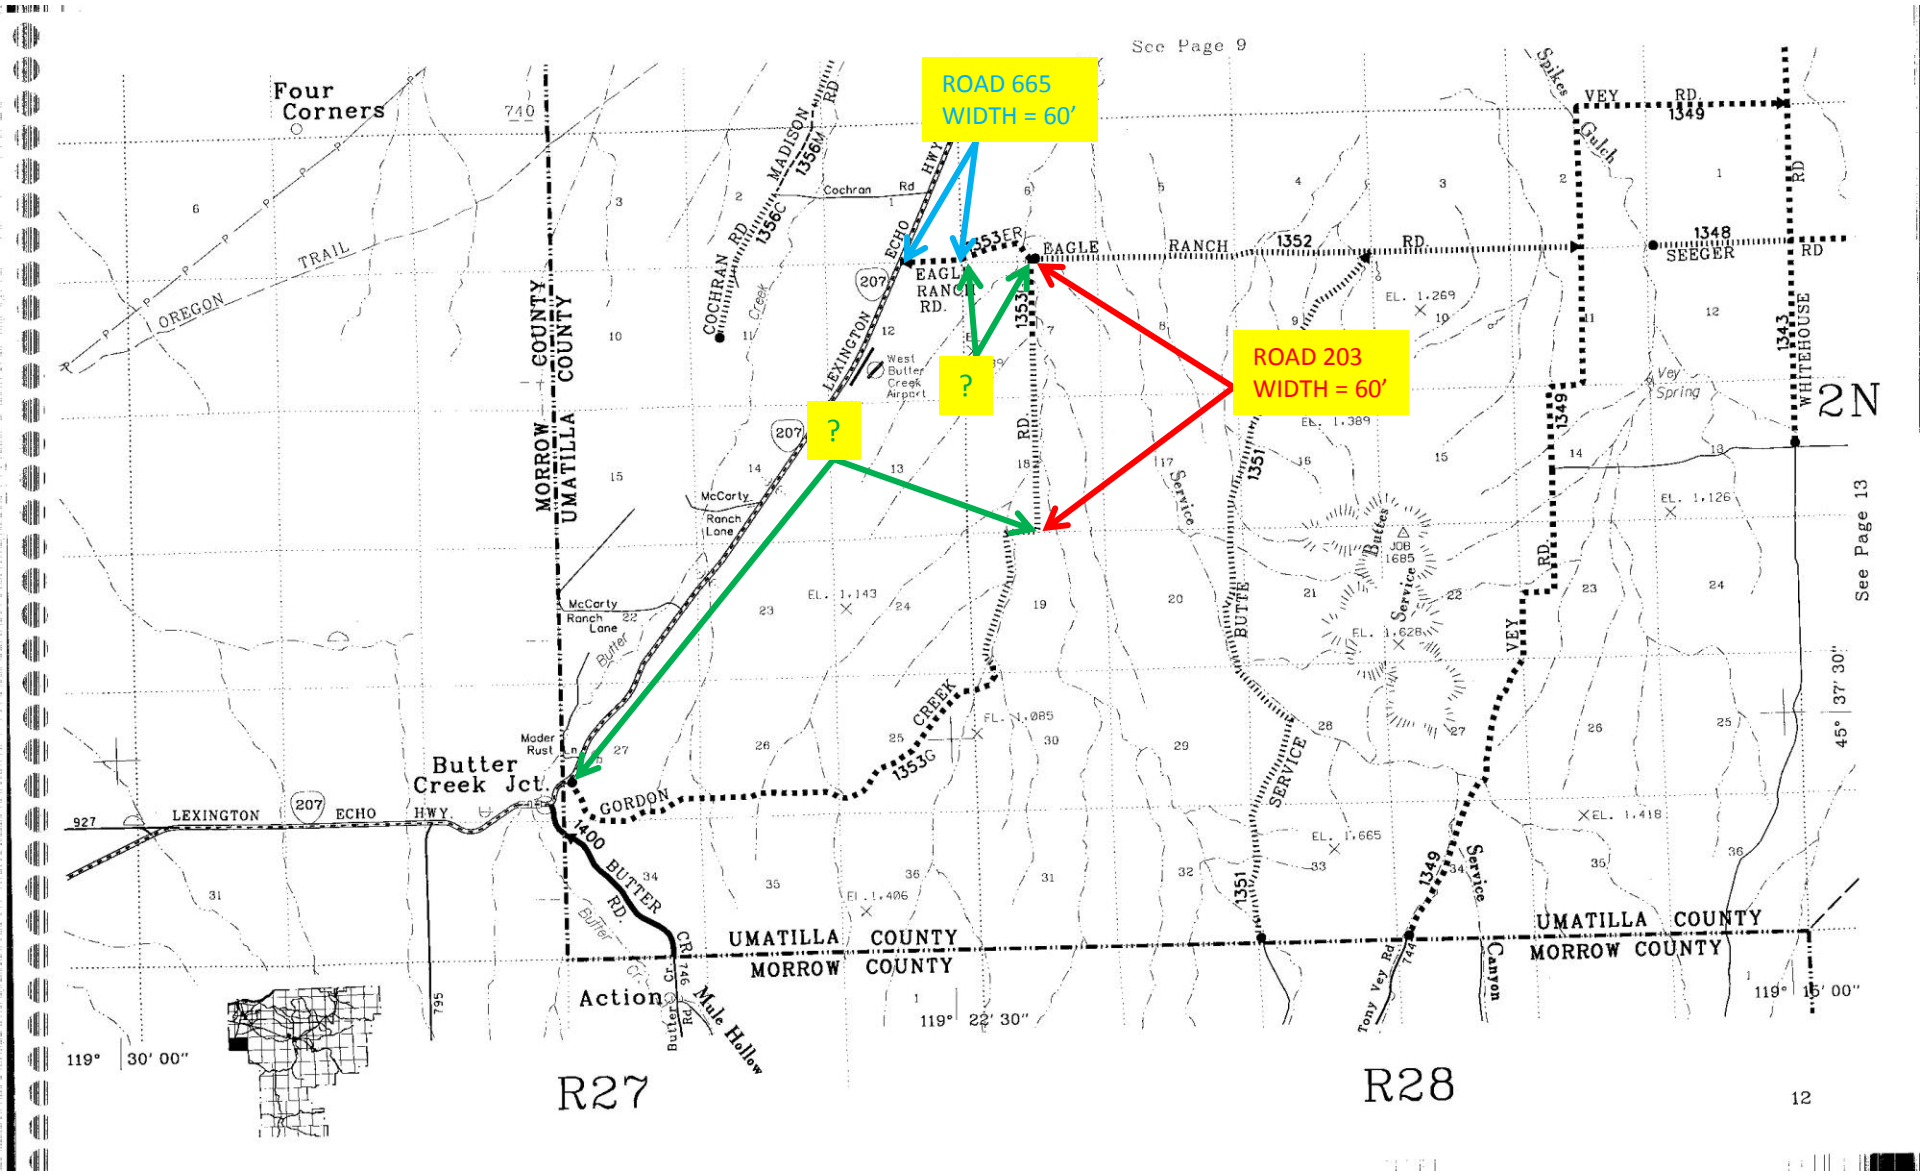

See Page 9
ROAD 665
WIDTH = 60'
ROAD 203
WIDTH = 60'
?
?
Four Corners
OREGON TRAIL
MORROW COUNTY
UMATILLA COUNTY
COCHRAN RD.
MADISON RD
LEXINGTON ECHO HWY
EAGLE RANCH RD.
EAGLE RANCH RD.
West Butter Creek Airport
McCarty Ranch Lane
Butter Creek Jct.
LEXINGTON ECHO HWY.
GORDON CREEK
BUTTER RD.
Mule Hollow
Action
UMATILLA COUNTY
MORROW COUNTY
BUTTE SERVICE
VEY RD.
SEEGER RD
WHITEHOUSE RD
Vey Spring
Spikes Gulch
Tony Vey Rd
Service Canyon
See Page 13
2N
R27
R28
119° 30' 00"
119° 22' 30"
119° 15' 00"
45° 37' 30"