


I certify that the above is a true copy of the field notes of the road surveyed by me commencing at the 23<sup>rd</sup> mile stake on the Unadilla city & McKay creek and running from thence to Pendleton: accompanying which is a plat of the same as taken from the notes

Chairman { E Campbell  
N Stoffer

J W Sharpe  
Surveyor

Rd-6  
BK-15-16

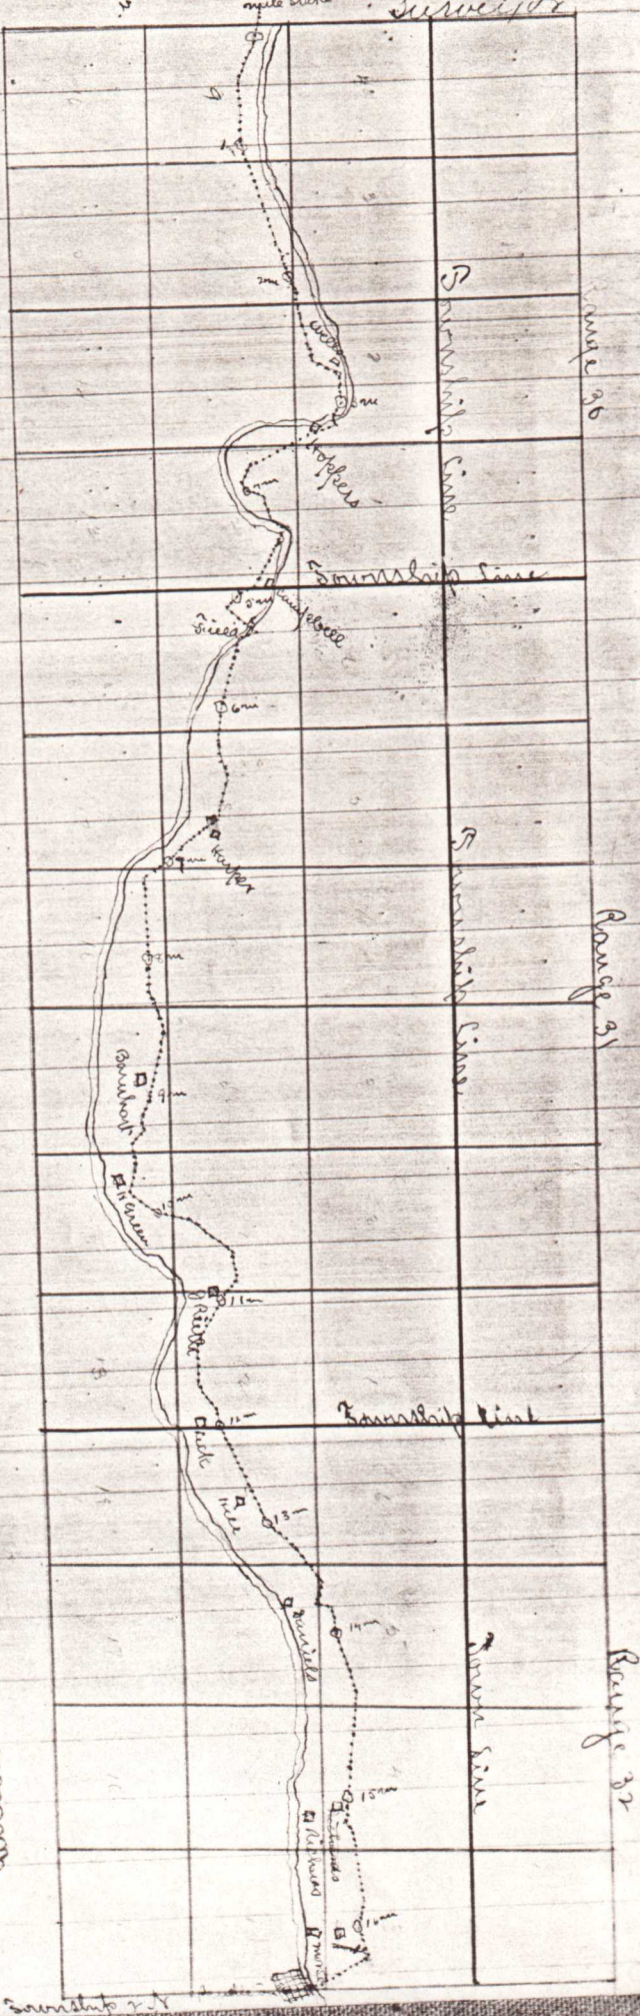

Road granted July 5<sup>th</sup> 1870  
See Co. Court Journal page 590

Surveyed by J W Sharpe