


Road Plat No. 499 T. 1, S. R. 2 E., W. 10.

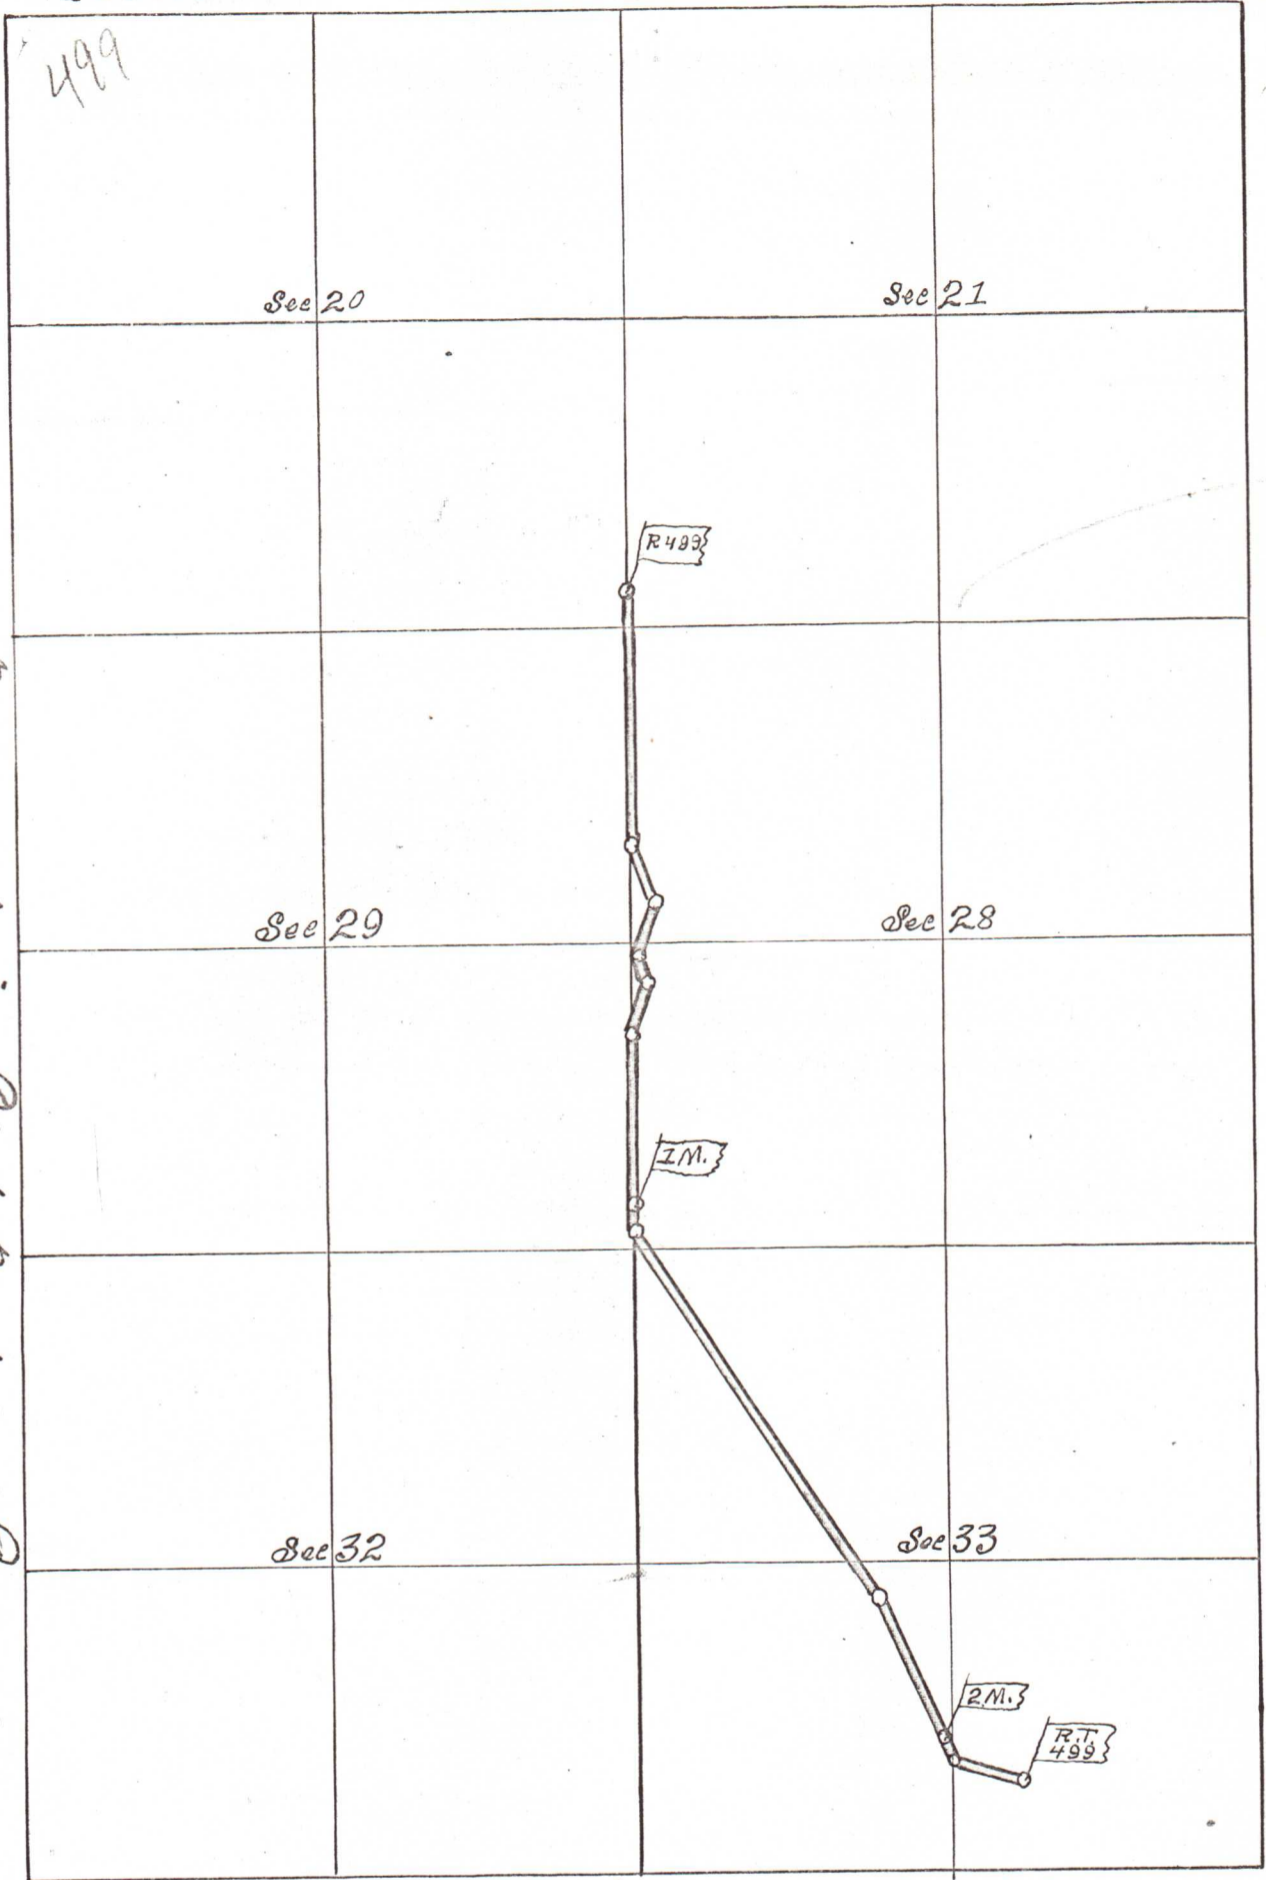

Recorded in Plat Book 921 Page 42

I hereby certify that the above is a correct Plat of Road No. 499 as surveyed by me on Aug. 22 1898
