


UMATILLA COUNTY
 ROADMASTER'S OFFICE.
EAST BIRCH CREEK HIGHWAY.
 CONSTRUCTED LINE.
 Scale 1"=400' Oct. 11, 1923.

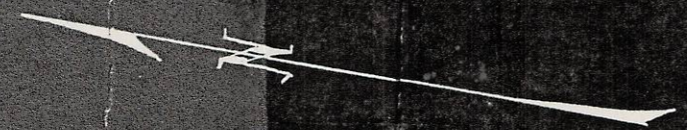

TWP. 1.S. - RANGE 32 E.

89
1716



S. 11° 38' E

16+50²

1931 L.

S. 13° 20' E

28+88 1/2 P.C.

4° 17' 12" R

16

20

32+103 P.T.

30+96

21

S. 0° 6' E

← --- 70 ft



78+94' P.C.
6° C.L.
16° 28'

81+68' P.T.

20+21
29+28

87+20

516' ± E

199'

96+95' P.C.

2° C.R.
11° 50'

102+87' P.T.

105+21
19' Std. Span.
Con. Abutments
12" T. Beam Stringers

541° 54' E

Old Road (Vacated)

137+43' P.C.

