

See Page 40


See Page 37

See Page 42

See Page 45

R32

R33

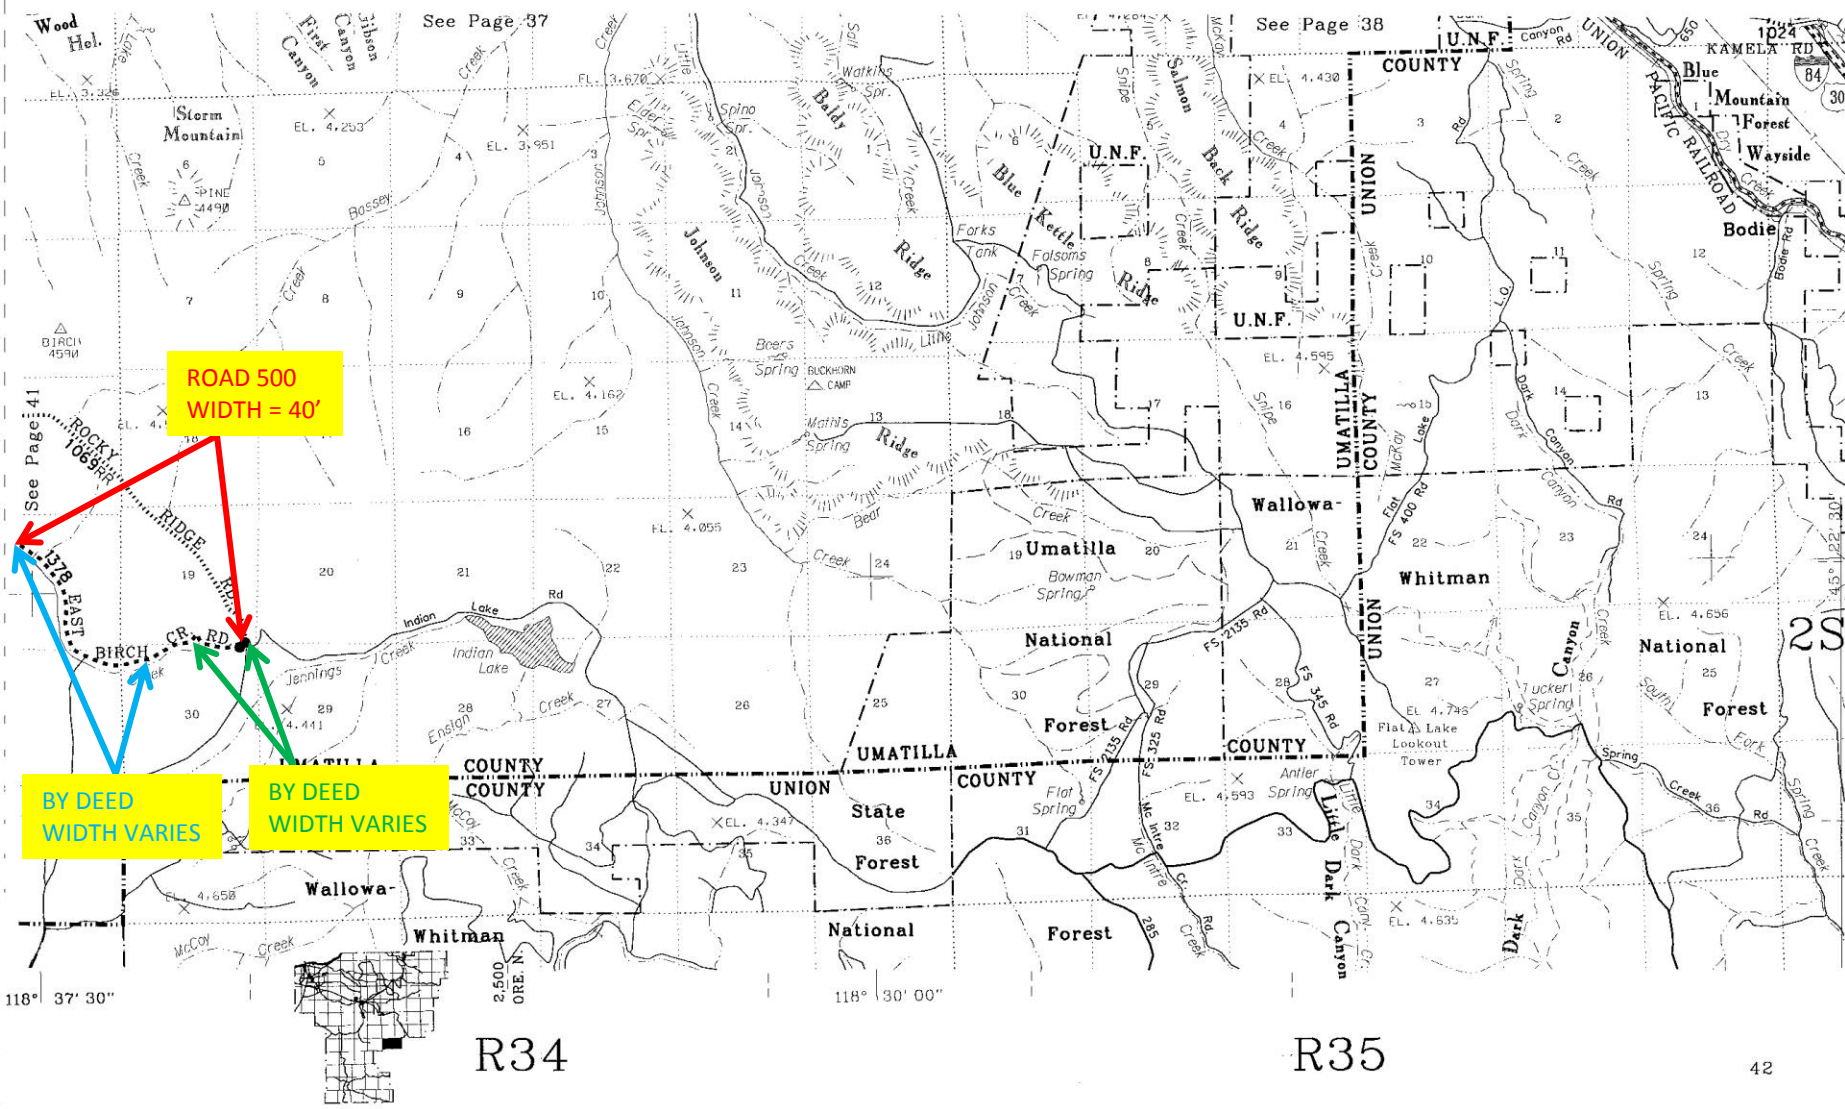

**ROAD 500
WIDTH = 40'**

**BY DEED
WIDTH VARIES**

**BY DEED
WIDTH VARIES**

118° 37' 30"

118° 30' 00"

R34

R35