

**ROAD 257
WIDTH = 60'**

**ROAD 600
WIDTH = 40'**

**ROAD 632
WIDTH = 40'**

**ROAD 257
WIDTH = 60'**

**ROAD 633
WIDTH = 60'**

See Page 30

See Page 14

See Detail Map
Page 67

See Page 32

119° 00' 00"

R31


118° 52' 30"

R32

118° 45' 00"

45° 30' 00"

31

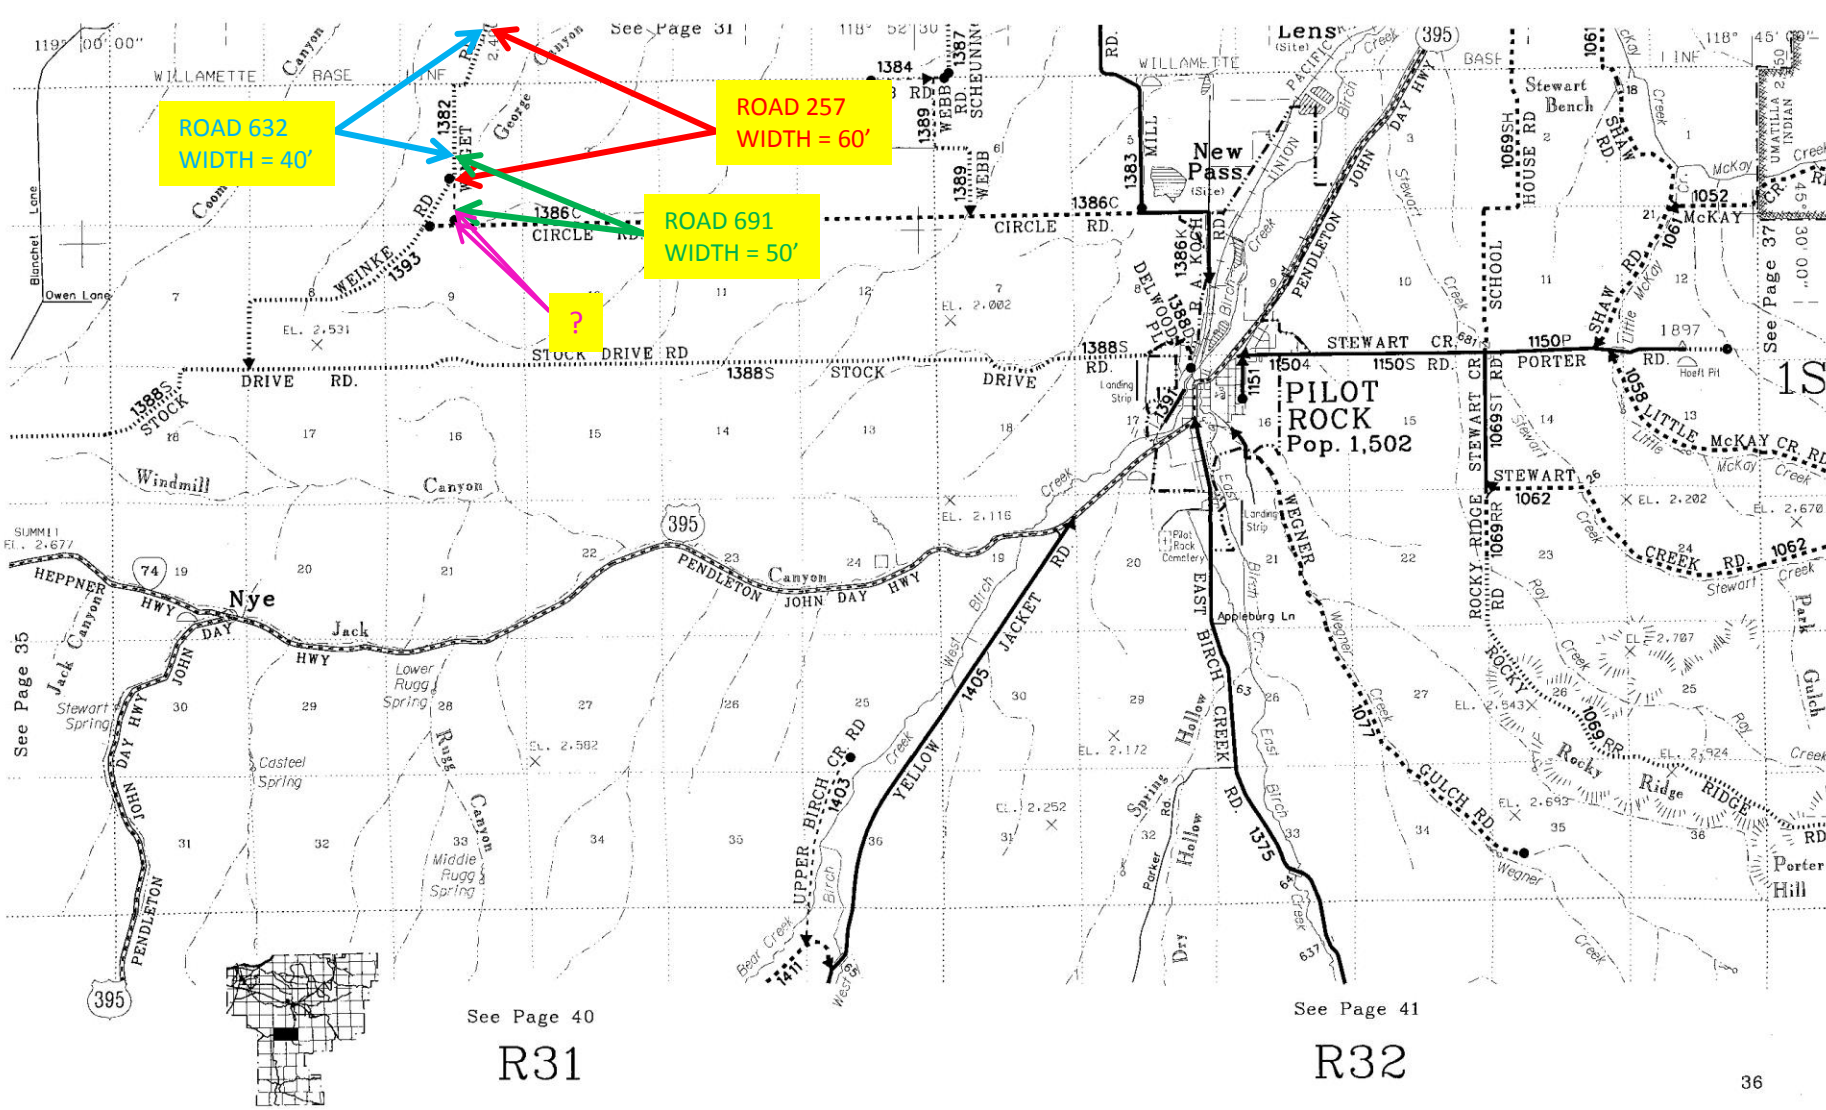

ROAD 632
WIDTH = 40'

ROAD 257
WIDTH = 60'

ROAD 691
WIDTH = 50'

?

See Page 31

See Page 40

R31

See Page 41

R32