

See Page 30

See Page 14

See Detail Map Page 67

See Page 32

**ROAD 161
WIDTH = 60'**

**LEGALIZATION 1976
WIDTH = 60'**

119° 00' 00"

R31

See Page 36

118° 52' 30"

R32


118° 45' 00"

45° 30' 00"

31

ROAD 161
WIDTH = 60'

LEGALIZATION 1976
WIDTH = 60'

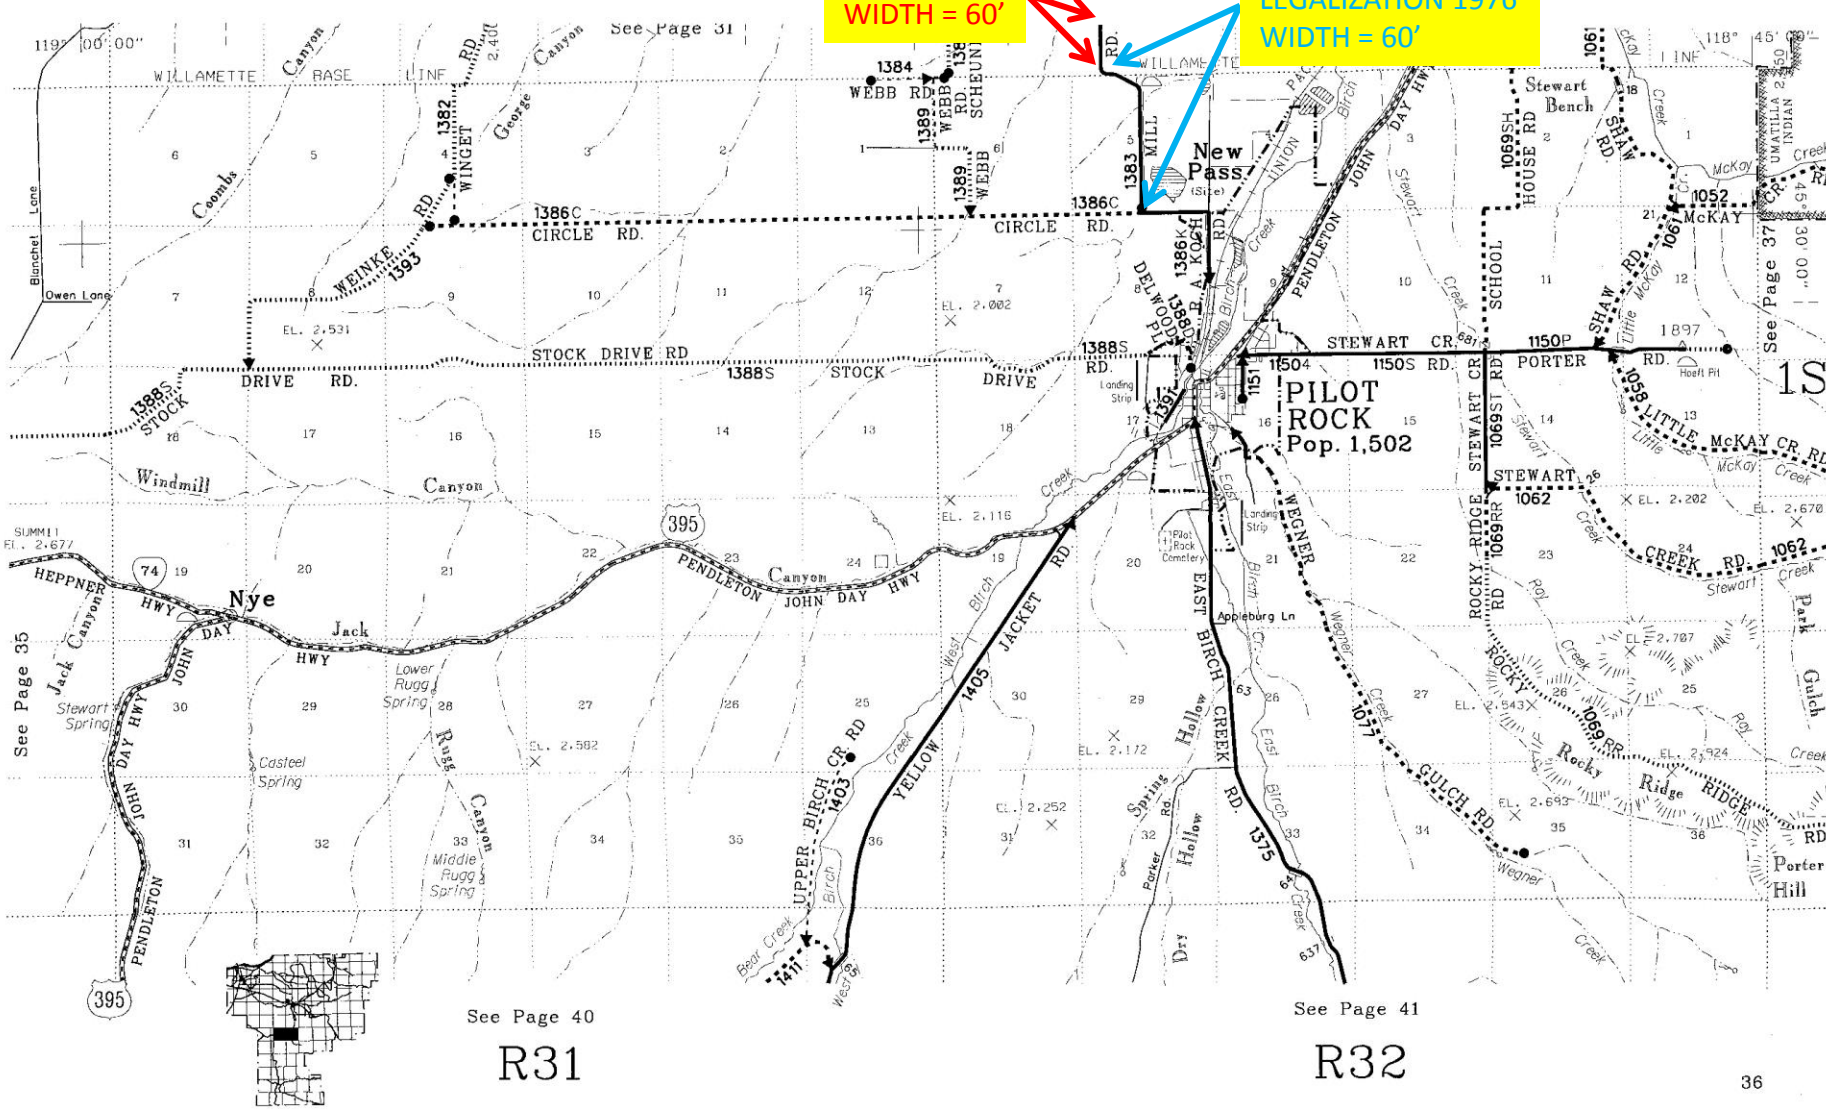

See Page 40

R31

See Page 41

R32