

See Page 35

See Page 36

See Page 41

See Page 44

R30

R30 1/2

R31

ROAD 349
WIDTH = 60'

BLUE'S RANCH ROAD
WIDTH = 60'

?

2S

45° 22' 30"

119° 07' 30"


119° 00' 00"

118° 52' 30"

2,350

2,400



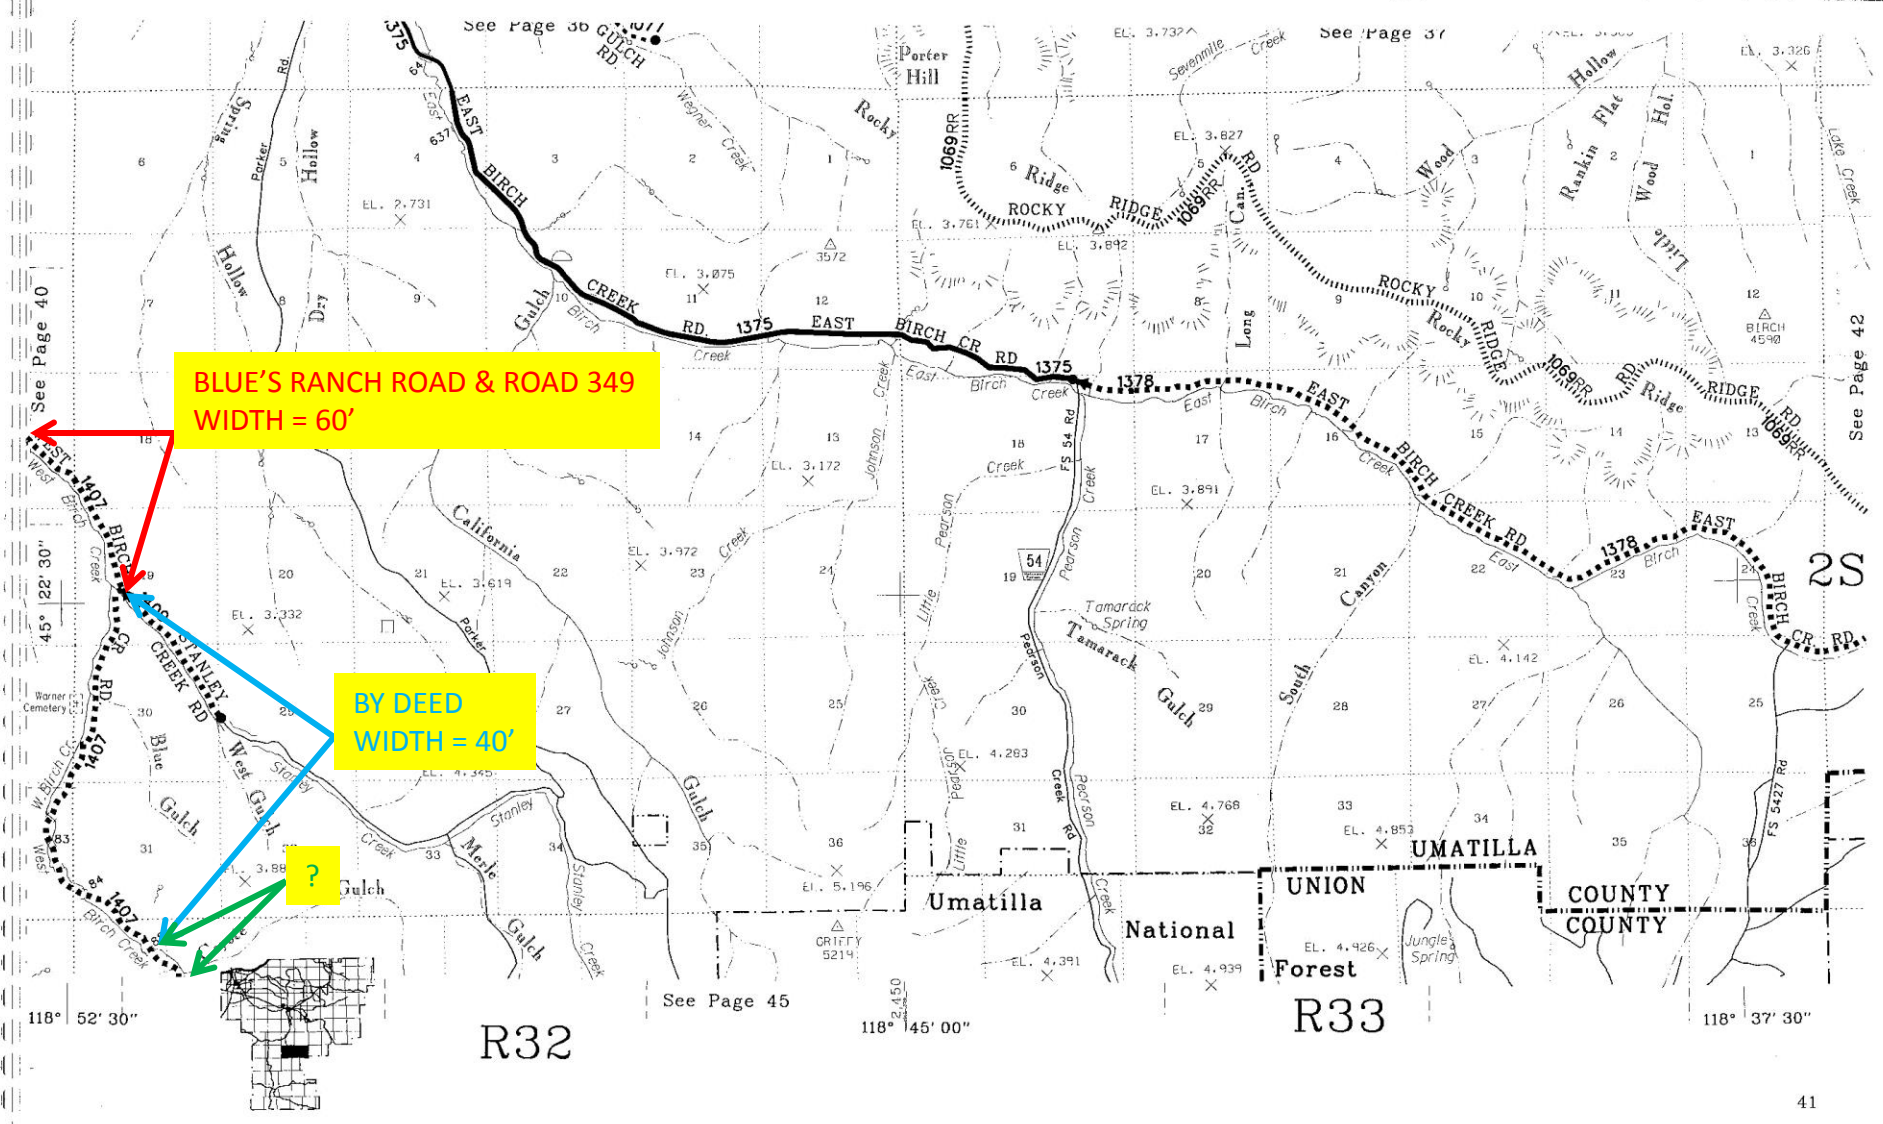

**BLUE'S RANCH ROAD & ROAD 349
WIDTH = 60'**

**BY DEED
WIDTH = 40'**

?

See Page 40

See Page 37

See Page 42

See Page 45


118° 52' 30"

118° 45' 00"

118° 37' 30"

R32

R33

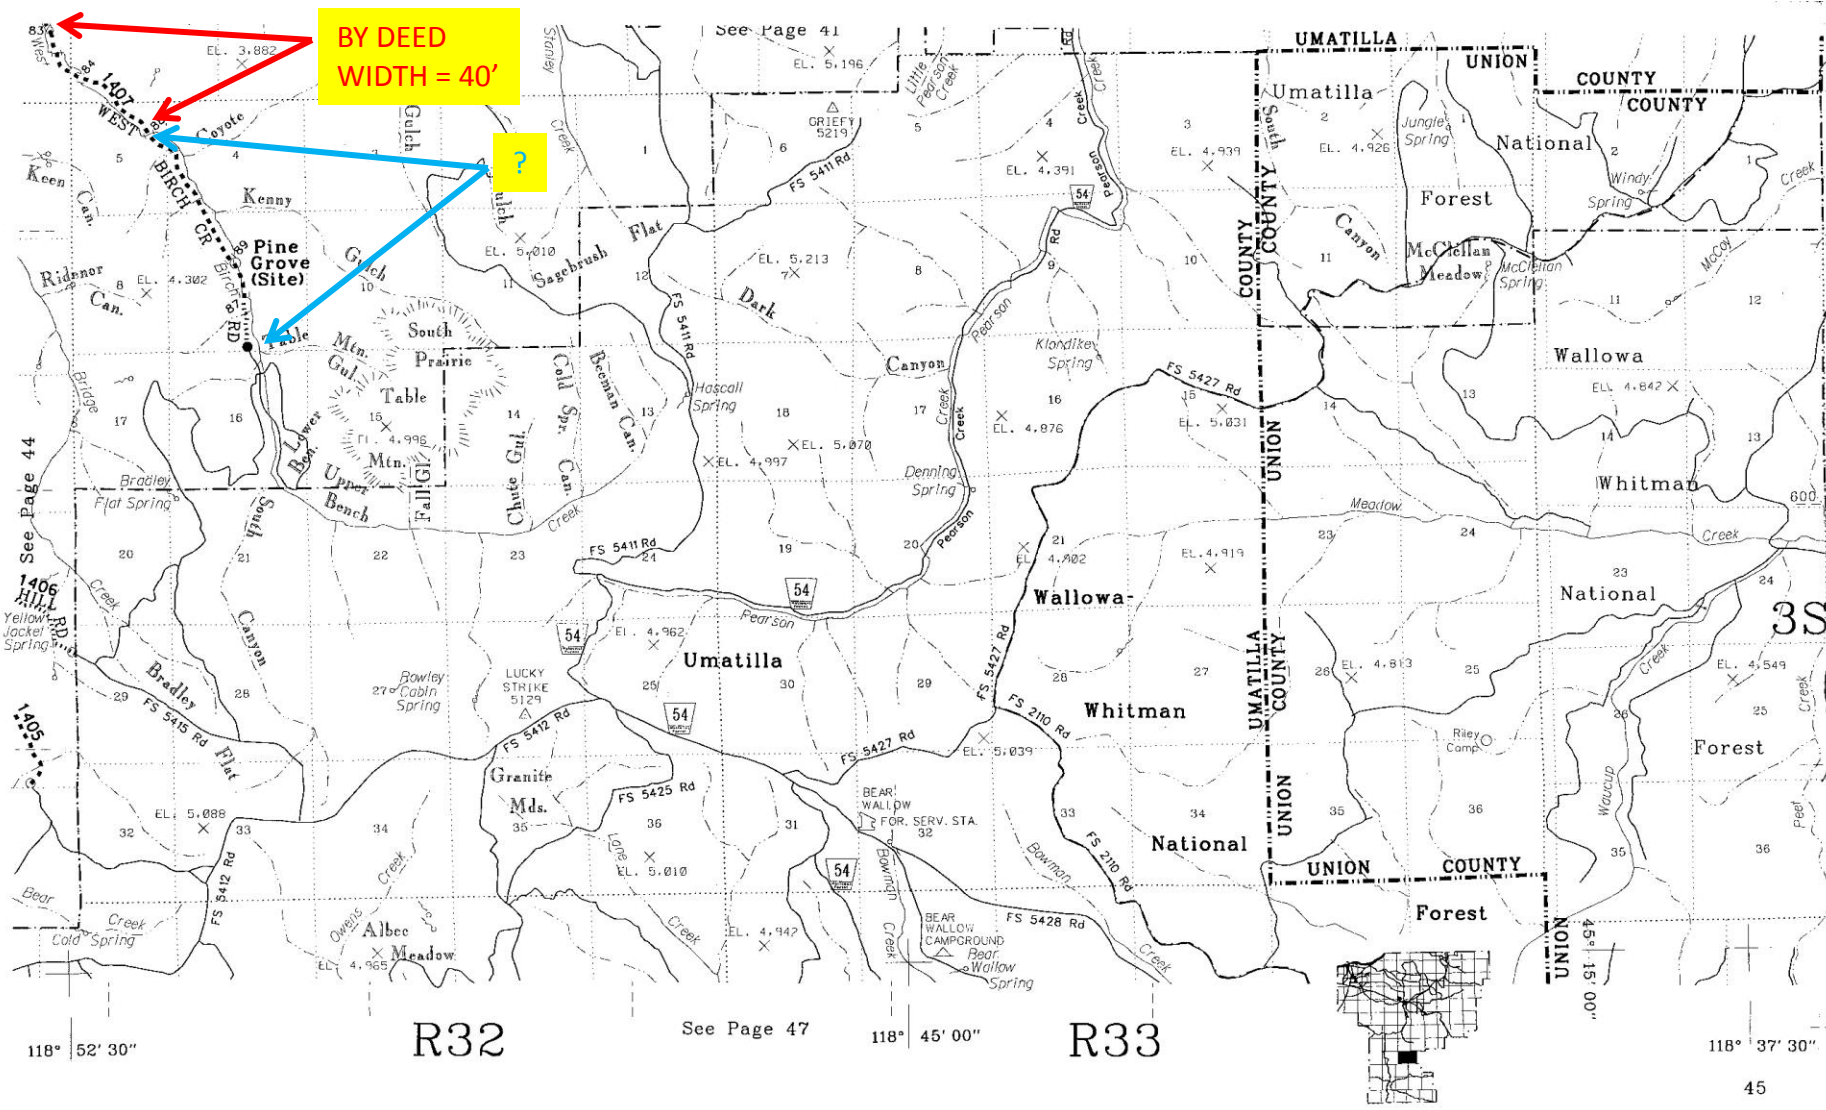

**BY DEED
WIDTH = 40'**

?

Pine Grove (Site)

See Page 44

See Page 41

See Page 47



118° 52' 30"

R32

118° 45' 00"

R33

118° 37' 30"