

See Page 35

See Page 36

**ROAD 32
WIDTH = 60'**

?

See Page 41

2S

45° 22' 30"

2,350 119° 07' 30"

119° 00' 00"

See Page 44

2,400

118° 52' 30"

R30


R30 $\frac{1}{2}$

R31

MORROW COUNTY 2.954
45° 15' 00"
119° 07' 30"

See Page 40

ROAD 32
WIDTH = 60'

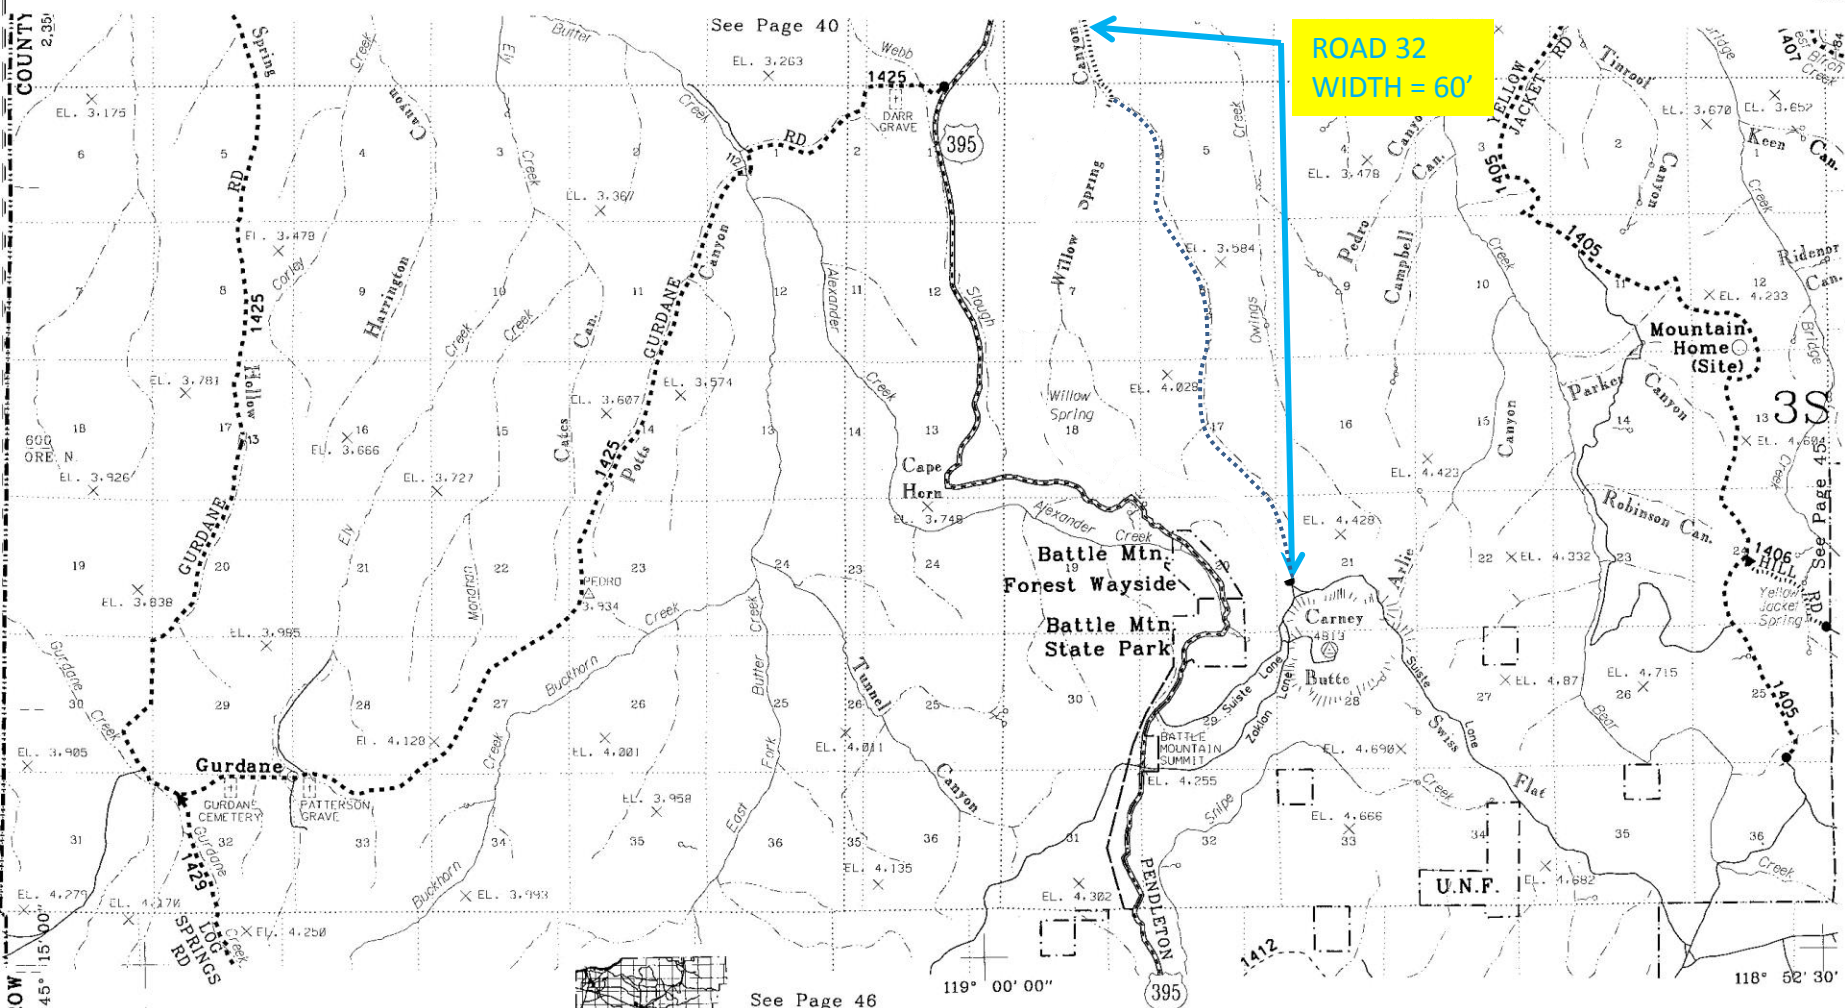

See Page 46

R30

R30 1/2

R31