

ROAD 275
WIDTH = 60'

ROAD 301
WIDTH = 60'

ROAD 448
WIDTH = 40'

See Page 46


See Detail Map of Ukiah Page 71

See Page 50

R30

See Page 52

R31

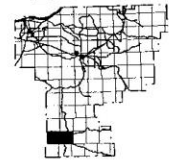


**ROAD 448
WIDTH = 40'**

**LEGALIZATION 1993
WIDTH = 50'**

**BY PLAT
WIDTH = 80'**

UKIAH
Pop. 186

WESTON
Pop. 695

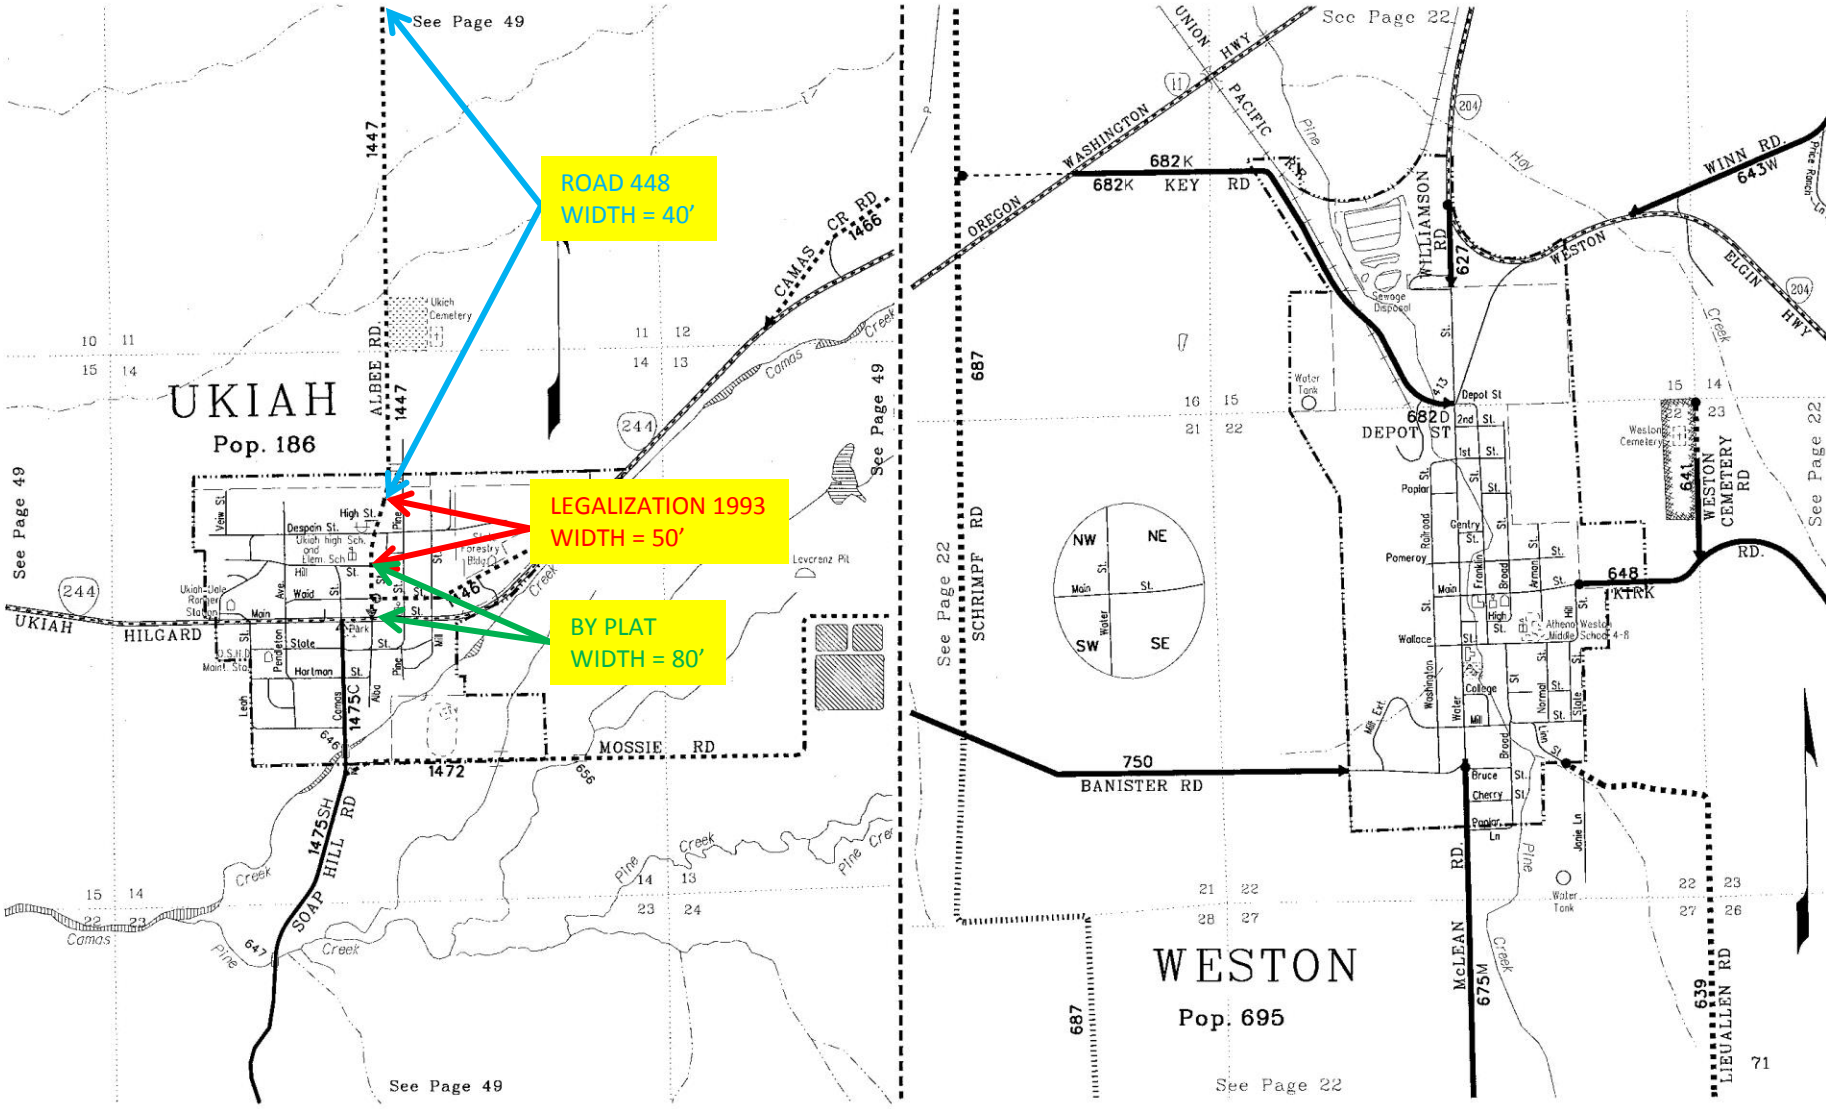

See Page 49

See Page 49

See Page 49

See Page 22

See Page 22

See Page 22

See Page 49

See Page 22