


See Page 49

See Page 22

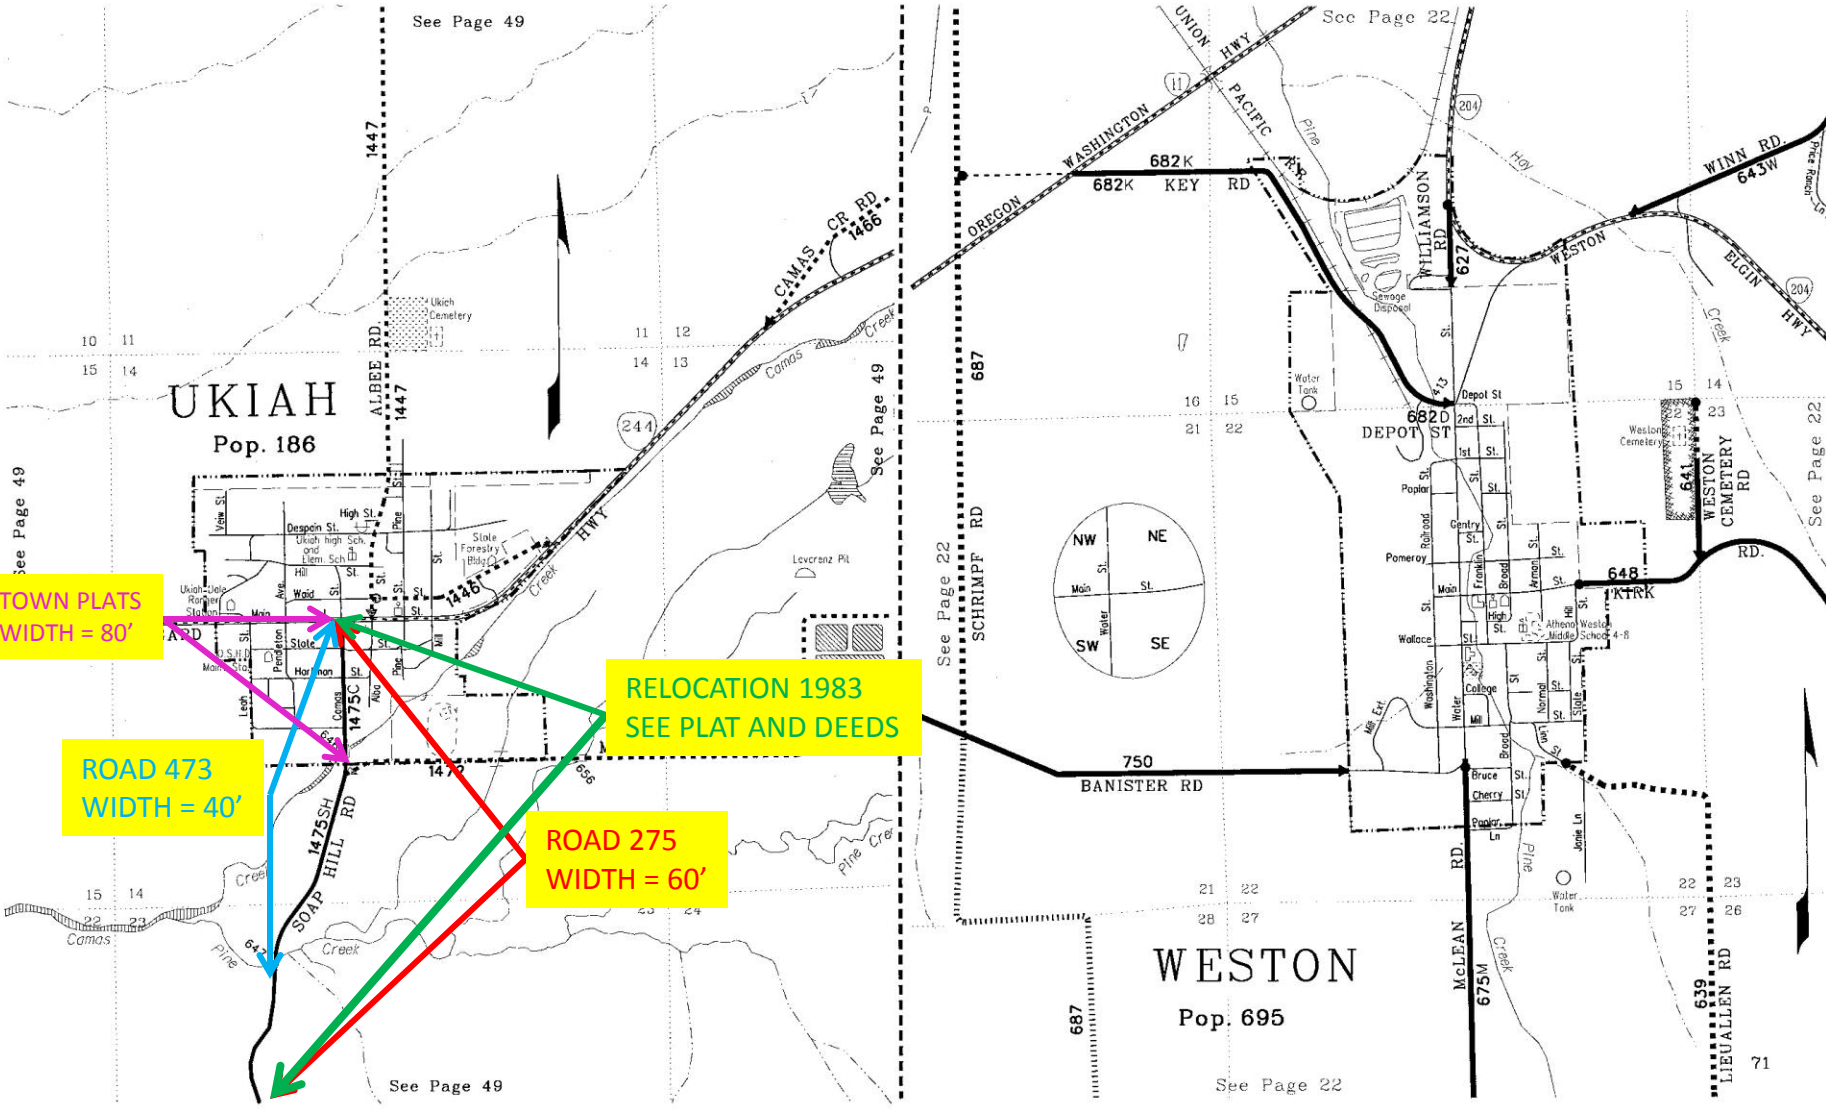

TOWN PLATS
WIDTH = 80'

ROAD 473
WIDTH = 40'

RELOCATION 1983
SEE PLAT AND DEEDS

ROAD 275
WIDTH = 60'

See Page 49

See Page 22

