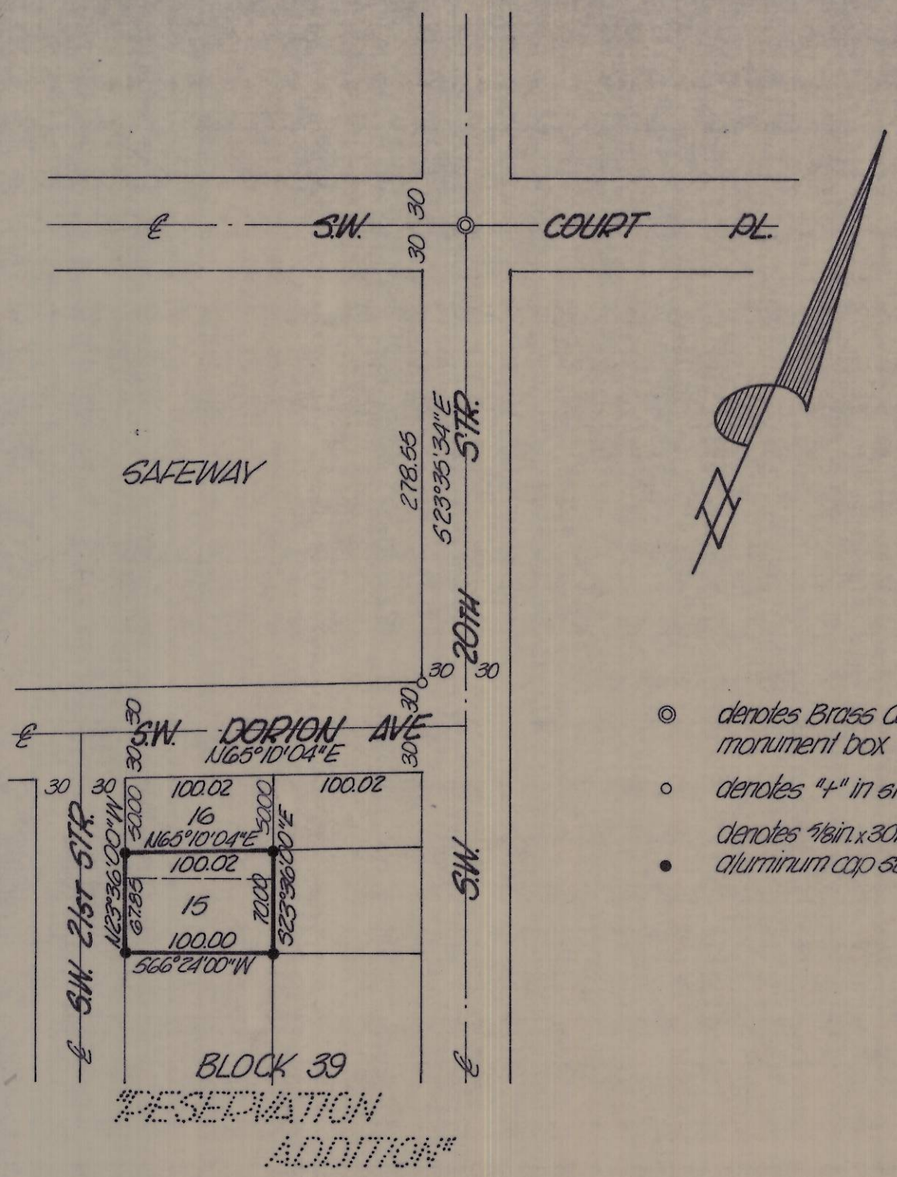

scale: 1" = 100'

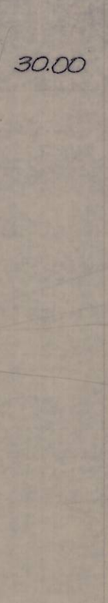

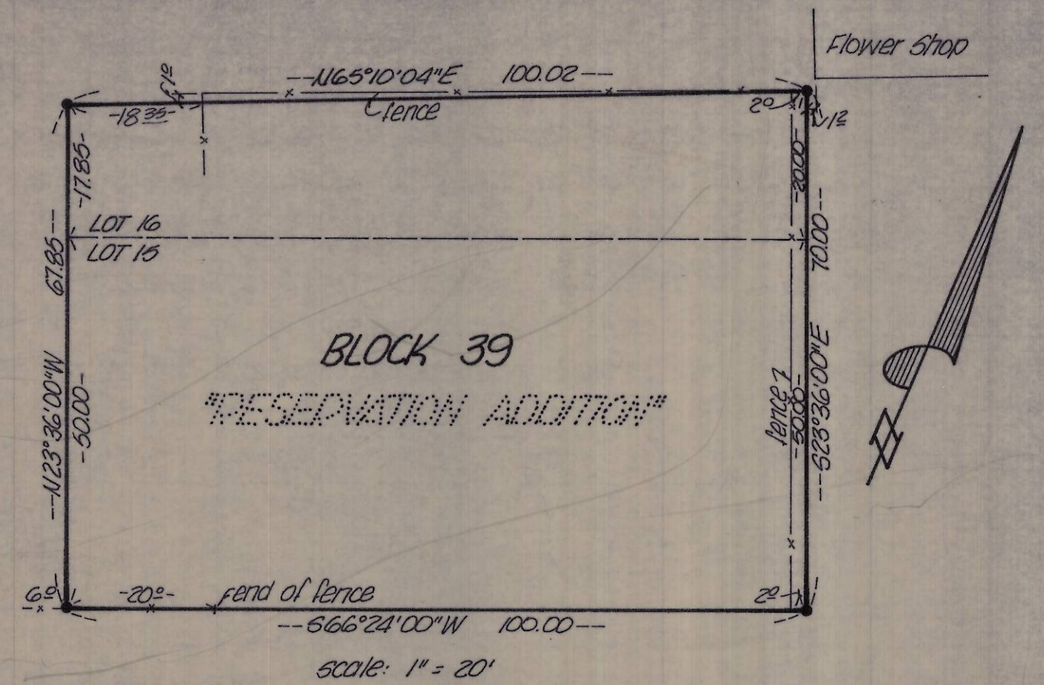

scale: 1" = 20'

◎ denotes Brass Cap found in monument box

○ denotes "+" in sidewalk found

● denotes 5/8in. x 30in. iron pin with aluminum cap set

NARRATIVE

The purpose of this survey was to mark the corners of that tract identified as Lots 15 and 16 of Block 39 in "Reservation Addition" to the City of Pendleton, Umatilla County, Oregon, less the North 50 feet thereof.

Control information used was from a survey by Bagett, Griffith and Associates for Safeway Stores, Inc., dated January 9, 1981, Umatilla County Survey Records drawing no. 5-65-C.

RECEIVED BY
Umatilla County Surveyor
Date 8-82
Rec'd By BLS
No. 82-34-A

REGISTERED PROFESSIONAL LAND SURVEYOR
David H Klein
OREGON
JULY 17, 1970
DAVID H. KRUMBEIN
638
David H Klein

KRUMBEIN ENGINEERING CO.
ENGINEERS – SURVEYORS – PLANNERS
221 S. Main, Pendleton, Oregon

Survey for
WHITNEY & ASSOCIATES
Lots 15 & 16, Block 39, "Reservation Addition," Pendleton, Oregon

SCALE	as shown
DATE	April 12, 1982
DRN. BY	MJ
CKD. BY	D.H.K.
DRNG. NO.	82-128

82-34-A Job No. 82-45