

NW cor. S 1/2 NE 1/4  
SE 1/4 Sec. 20  
Fnd 2" I.P.  
Cramer 198?

Fnd Bent 3/4  
I.P. Cramer  
198?

Wire Fence

335.40'  
73'  
354.23'  
N 0°55'30"W 1115.99'  
Bearing Base Cramer's 198? sur. for Griffiths  
N-S E SE 1/4 Sec. 20  
This line lies 8'± East of a fence line & power line  
but generally follows the top of a dirt ridge that  
runs North & South


Fnd 1/2" I.P. 08'  
West of Line  
Cramer 198?  
for Griffiths  
Fnd 3/4" I. Rod  
Cramer 1979 sur.  
for Griffiths  
"A" CANAL

--- N 89° 49' 40" E 1358.41' ---  
468.46'  
468.19'  
481.95'  
482.25'  
--- N 89° 49' 40" E ---

Note: This line generally follows an old tree line fence along the tree line. A line runs south of the tree line.

NE cor. S 1/2  
NE 1/4 SE 1/4  
Sec. 20  
Fnd 1/2" I. Rod  
set  
in by me  
sur. for  
KENNEY  
in Sec. 21  
Co. Rd. 614  
S 1002 46'E  
33'

NARRATIVE: The purpose of this survey is to stake the N. 16.5 ft. of the S 1/2, NE 1/4, SE 1/4 of Sec. 20 & part of the N-S E of the SE 1/4 of Sec. 20 to determine how the fence lines match the Deed lines.  
This survey is based on the section subdivision as depicted on my survey for Davis in 1984 which is the same subdivision used by Cramer in his 1979 & 198? surveys for Griffiths.

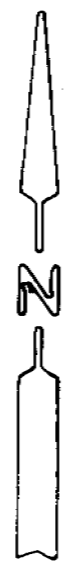

SCALE: 1" = 100'  
• Monuments Found  
○ 1/2" x 24" I. Rods set with Alum. Tag # 951

REGISTERED  
PROFESSIONAL  
LAND SURVEYOR  
*G. Dennis Edwards*  
OREGON  
JULY 15, 1971  
G. DENNIS EDWARDS  
951

RECEIVED BY  
Umatilla County Surveyor  
Date 6-17-86  
Rec'd By EA  
No. 86-68-A

SURVEY FOR MARY NEWMAN  
IN SE 1/4 Sec. 20, T 4 N, R 2 E, W.M. UMATILLA CO., OR.  
5/22/86 Job # 58605024  
EDWARDS SURVEYING P.O. BOX 763  
567-3336 HERMISTON, OREGON

86-68-A