

Find BC. Stated Umatilla Co. Surveyor

W 1/4 Cor. Computed from 1977 Krumbein Survey Do not use for Northings as bearing base may not be the same as mine

(N 77° 50' 35" W) 1366.49' Painted to U.S. Hwy # 730 1973 Krumbein Survey Plat of McNary Township N 77° 50' 00" W, Bearing Base to OR. State Hwy Div. R/W Map

C. KIK et ux B 302, P 292

Deed says this line is parallel with S. line of lot 11. I did not completely subdivide the section so made this line parallel with the south line of the sec. the which should be nearly the same.

NARRATIVE:
The purpose of this survey is to partition out of the W 1/2 SW 1/4, sec. 14, a parcel as directed by Mr. KIK, to stake it, to describe it, and to compute the acreage.



REGISTERED PROFESSIONAL LAND SURVEYOR

G. Dennis Edwards

OREGON
JULY 18, 1971
G. DENNIS EDWARDS
951

SCALE: 1" = 200'
(000) of record
● monuments Found
○ 5/8" x 30" Iron rods set with Alum. tag. #951

RECEIVED BY
Umatilla County Surveyor
Date 10-29-86
Rec'd By RA
No. 86-128-A

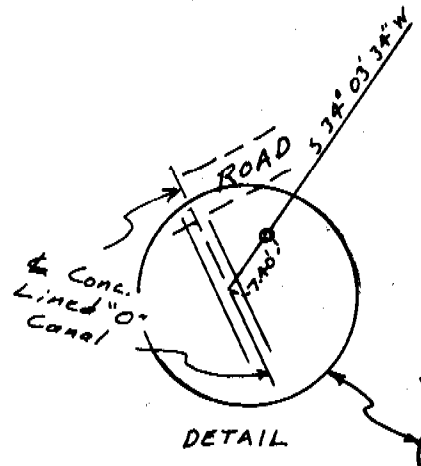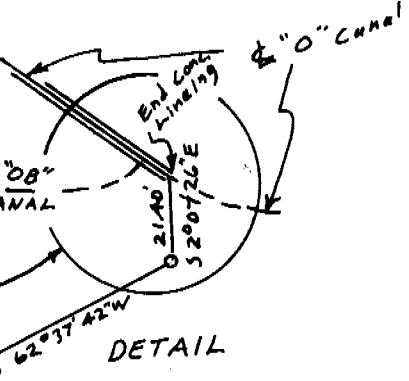

44.25 Acres ±

N 0° 37' 14" W 5387.18

CO. RD. # 624 not in use 2039.14'

Find BC. in Conc. U.S. no date

N 0° 29' 51" W 5414.32'

2039.09'

S 89° 58' 57" E 1331.89'

1298.89'

S 34° 03' 34" W 647.14'

S 34° 03' 34" W 639.74'

S 24° 23' 05" E 457.54'

S 4° 54' 20" E 409.27'

S 55° 58' 38" E 674.0'

S 62° 37' 42" W 1346.56'

1327.51' S 89° 58' 57" E 2655.02' (N 89° 59' 17" E 2655.23' My 1978 Sun for Conforth)

SURVEY FOR CHARLES KIK
IN SW 1/4 sec. 14, T 5N, R 2BE,
W.M. UMATILLA CO., OREGON
6/25/86 Job # 58606027
EDWARDS SURVEYING Box 763
567-3336 HERMISTON, OR.

Find BC. in Conc. U.S. 1/4 Cor. 23

86-128-A