
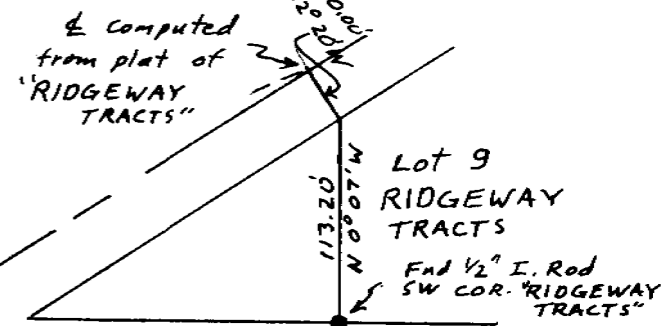


- Monuments Found
 - 1/2" x 24" Rebar set with Alum. Tag #951
- (000) of Record Plat of "HERMISTON ORCHARDS" 1909

REGISTERED
PROFESSIONAL
LAND SURVEYOR

G. Dennis Edwards

OREGON
JULY 16, 1971
G. DENNIS EDWARDS
951

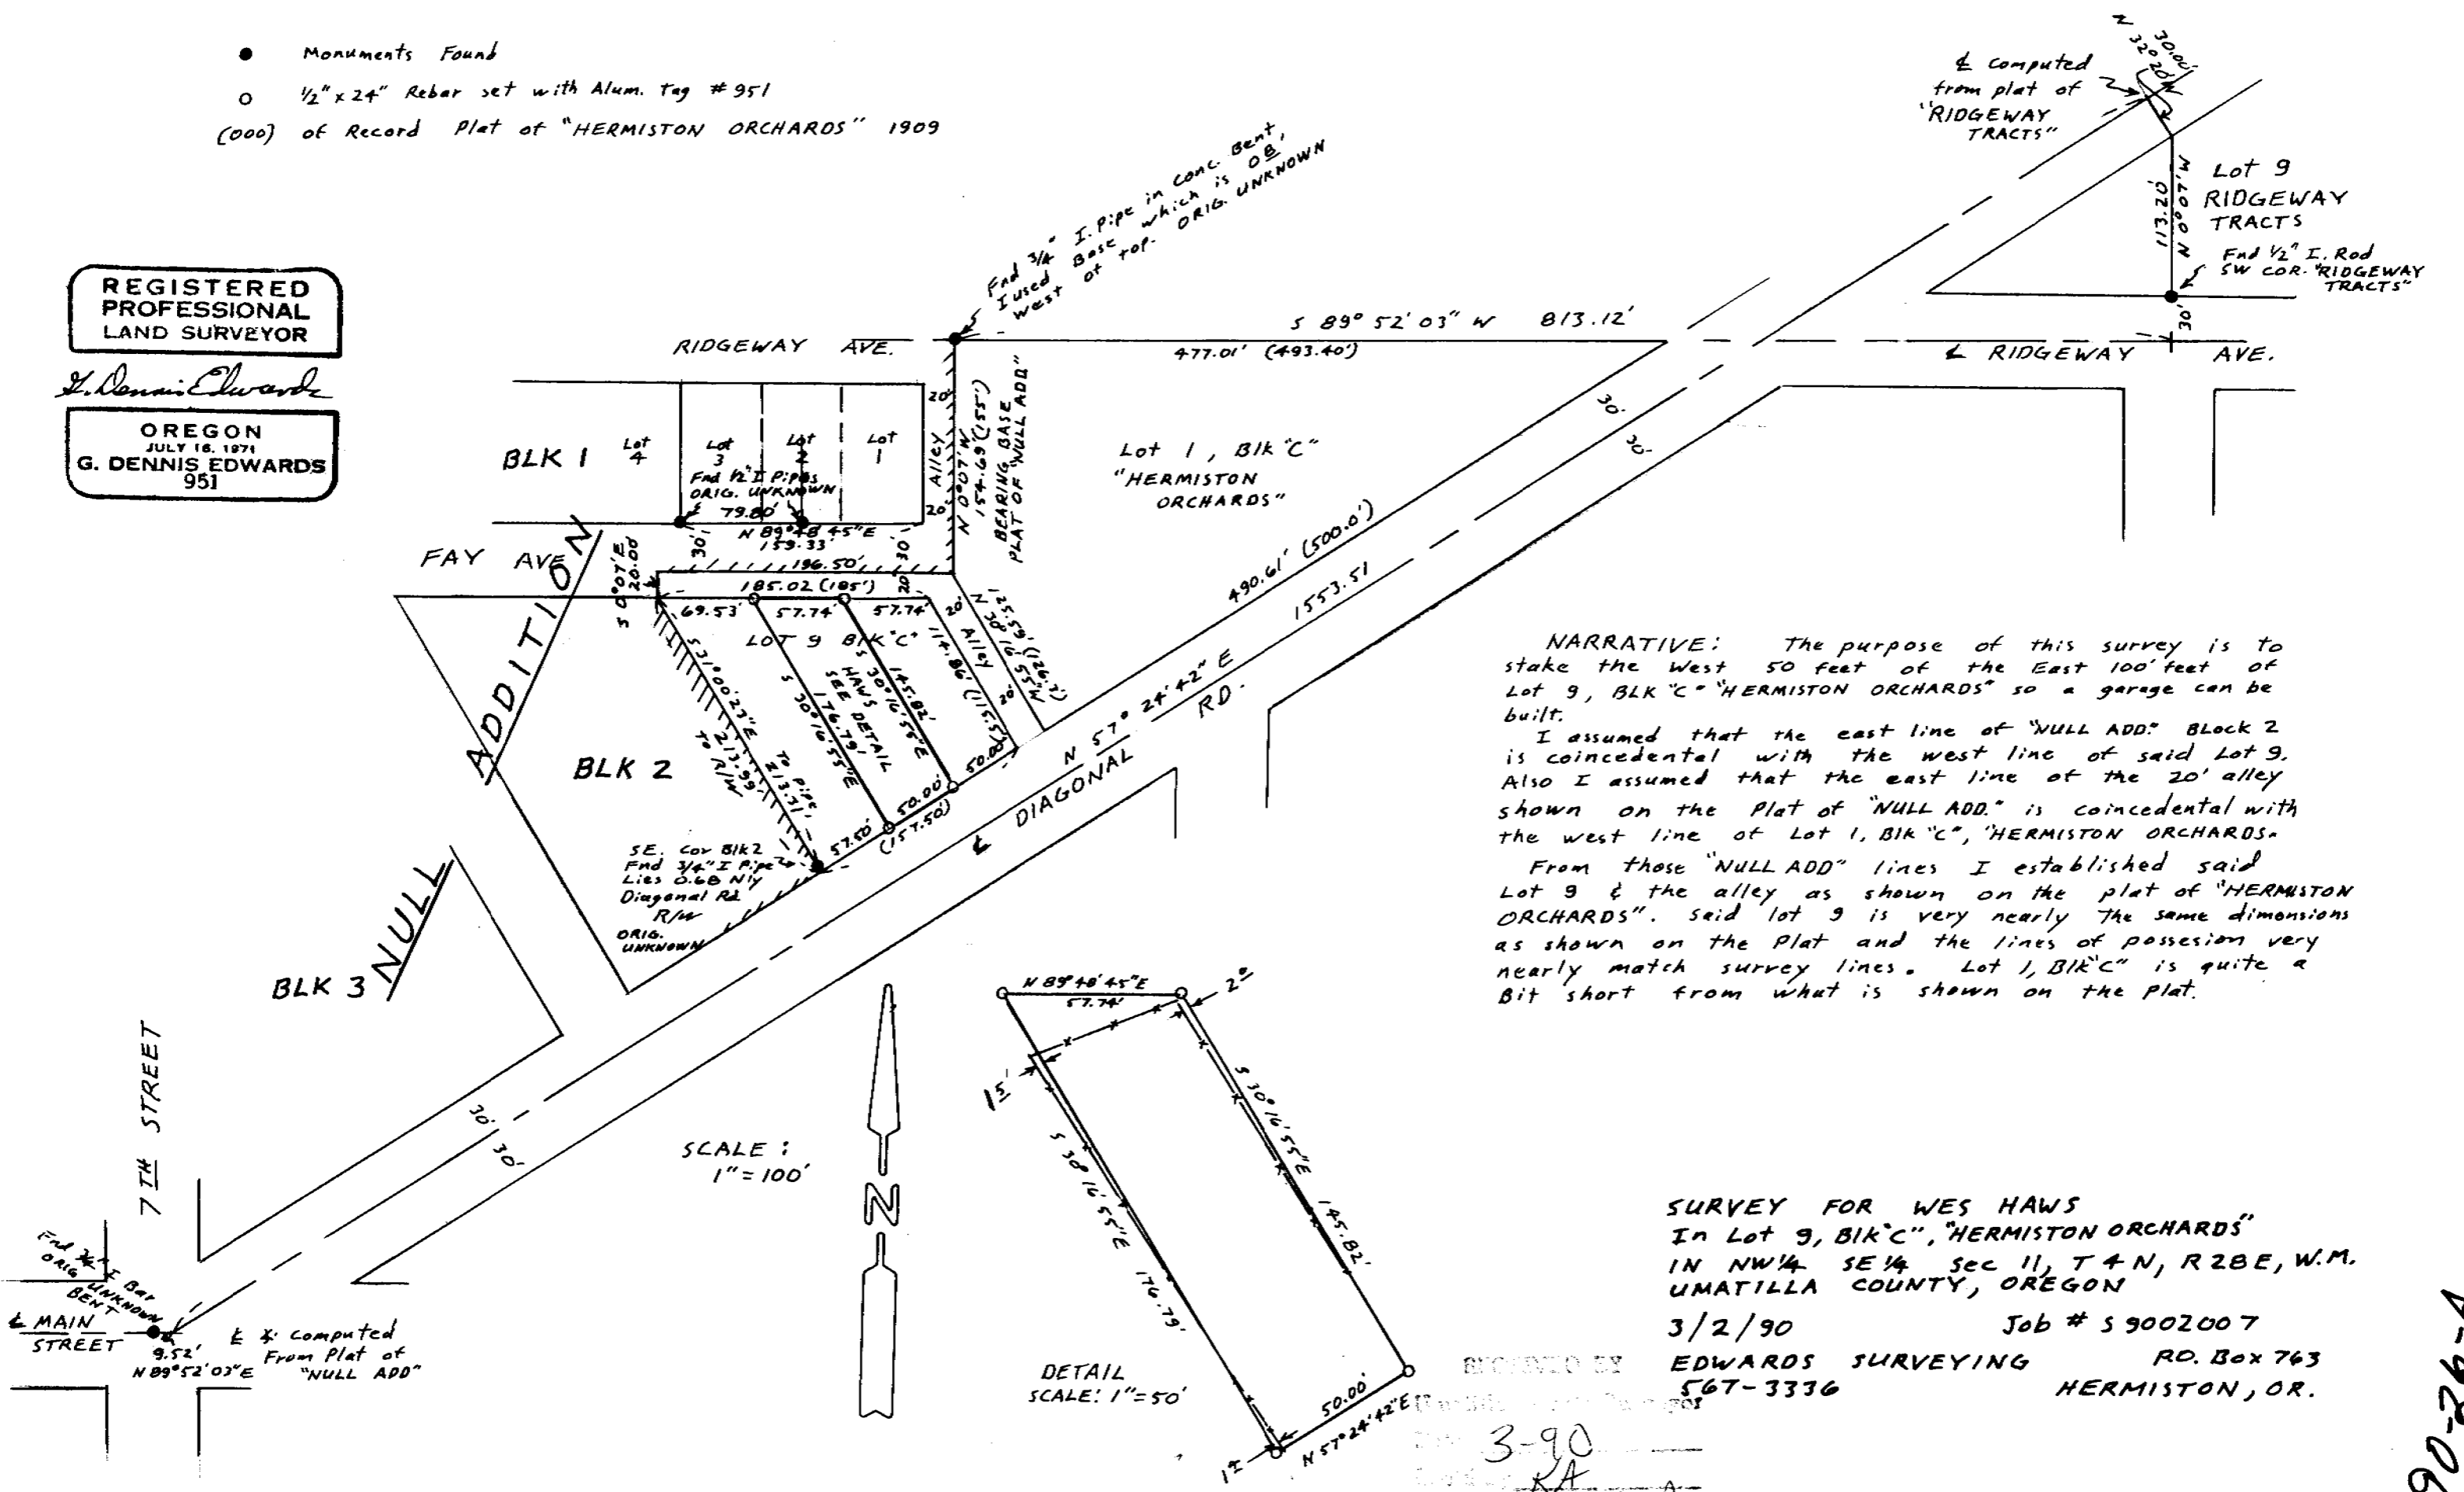

NARRATIVE: The purpose of this survey is to stake the West 50 feet of the East 100' feet of Lot 9, BLK "C" "HERMISTON ORCHARDS" so a garage can be built.

I assumed that the east line of "NULL ADD" Block 2 is coincidental with the west line of said Lot 9. Also I assumed that the east line of the 20' alley shown on the Plat of "NULL ADD" is coincidental with the west line of Lot 1, BIK "C", "HERMISTON ORCHARDS".

From those "NULL ADD" lines I established said Lot 9 & the alley as shown on the plat of "HERMISTON ORCHARDS". said lot 9 is very nearly the same dimensions as shown on the Plat and the lines of possession very nearly match survey lines. Lot 1, BIK "C" is quite a bit short from what is shown on the plat.

SURVEY FOR WES HAWS
In Lot 9, BIK "C", "HERMISTON ORCHARDS"
IN NW 1/4 SE 1/4 Sec 11, T 4 N, R 2 E, W.M.
UMATILLA COUNTY, OREGON

3/2/90 Job # 59002007
EDWARDS SURVEYING R.O. Box 763
567-3336 HERMISTON, OR.

RECORDED BY
3-90
KA
90-26-A

90-26-A