

End. 2 1/2" B.C. Krumbein, 1980 for Co.

My 1990 Sur. for Campbell. (S 89°24'22" W 885.57) E

S 89°44' E 33.00'

End. 2 1/2" B.C. set by Krumbein lying horizontal. Reset @ Krumbein's loc. from ties to my 1990 Campbell survey.


End. 5/8" rebar, 0.80' S. & 0.20' E. Origin unknown.

Sec. 3, N 1/4 Cor. End. 2 1/2" B.C. Krumbein, 1980 for Co.

S 1/4 Cor. Sec. 34. End. P.K. nail straddles. Krumbein, 1980, for Co.

**PUNKIN CENTER ROAD**

Bearing Base: My 1989 Survey for A. Richardson in Sec. 34.

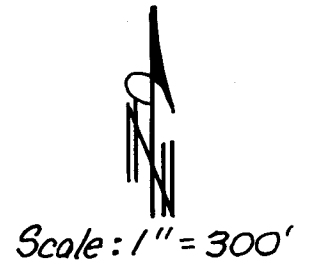

**NARRATIVE:**

The purpose of this survey is to adjust the boundary of a home site for a pending sale. Said home site is part of an approximately 25.5 acre parcel described as Parcel 16, on Reel 238, Page 523. Ambrose Shea had set the NW corner of this parcel in a 1972 survey for Golden West Corp., but it is off by about 0.9 foot from monumented Section Corners.

**LEGEND:**

- Found monuments, as noted.
- o Set 5/8" x 30" rebar with plastic cap #951.
- (ooo) of Record.
- P Palmer's 1976 Survey, #K-16.
- E Edwards' 1990 Survey for Campbell.

**REGISTERED PROFESSIONAL LAND SURVEYOR**

*G. Dennis Edwards*

OREGON  
JULY 16, 1971  
**G. DENNIS EDWARDS**  
951

Loc. 1/4 Corner computed from Palmer's 1976 Sur. #K-16.

C 1/4 Corner. End. 2 1/2" B.C. Krumbein, 1980 for Co.

RECEIVED BY  
Umatilla County Survey  
Date 12-93  
Dwd'd By JK  
No. 93-109-A

Survey for **CHARLOTTE DACK**  
In the NE 1/4, NW 1/4 Section 3, T4N, R28E, W.M.,  
Umatilla County, Oregon  
9/23/93 Job #59309060  
Edwards Surveying P.O. Box 763  
567-3336 Hermiston, OR. 97838

93-109-A