

NARRATIVE:

The purpose of this survey is to find and or set the corners of Lot 1 so a manufactured home can be sited.

I set the missing corners from the original ones which were found as noted. All bearings and distances shown are the same as the original Plat of "CONFORTH'S FIRST ADDITION."


REGISTERED
PROFESSIONAL
LAND SURVEYOR

G. Dennis Edwards

OREGON
JULY 16, 1971
G. DENNIS EDWARDS
951
RENEWS 12/31/97

LEGEND:

- Found monuments: Original Plat "CONFORTH'S FIRST ADDITION," by D. Staebler.
- Set 5/8" x 30" rebar with plastic cap #951.

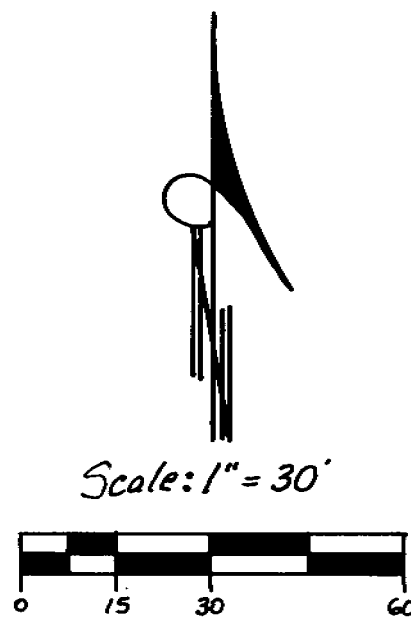

RECEIVED BY

Umatilla County Surveyor

Date 01-97

Rec'd by KK

No. 97-08-A

Survey for JACK NEWELL
In Lot 1, Block 5, "CONFORTH'S FIRST ADD." to City of Umatilla,
In NW 1/4 Section 20, T5N, R28E, W.M.,
Umatilla County, Oregon
11/6/96 Job #59610224
Edwards Surveying P.O. Box 763
541-567-3336 Hermiston, Oregon 97838

97-08-A