


**NARRATIVE:**

The purpose of this survey is to stake the South line of the NE 1/4 of the NE 1/4 of the NE 1/4 of Section 11 to see where a recently built fence lies in relation to it. Fraley surveyed this line in an undated survey (Co. #Q-625-Ax) and I found his West corner 0.50 feet North and 3.63 feet West of the true corner. I also found his corner 329.5 feet South of the West one and it was supposed to be 331 feet South, so I assumed that his survey was in error. The constructed centerline of 10th Street lies about 14 feet East of the Section line at this property.

**LEGEND:**

- Found monuments, as noted.
- Set  $\frac{5}{8}'' \times 30''$  rebar with plastic cap #951.
- (ooo) of Record. Fraley, survey #Q-625-Ax.
- [ooo] of Record. Krumbein's 1981 Co. survey.
- {ooo} of Record. My 1992 Sur. for May in Sec. 12.

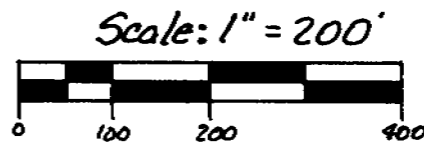

REGISTERED  
PROFESSIONAL  
LAND SURVEYOR

*G. Dennis Edwards*

OREGON  
JULY 16, 1971  
G. DENNIS EDWARDS  
951  
RENEWS 12/31/97

Survey for GARY TENNANT  
In the NE 1/4 Section 11, T4N, R28E, W.M.,  
Umatilla County, Oregon  
2/10/97 Job #59612277  
Edwards Surveying P.O. Box 763  
541-567-3336 Hermiston, OR. 97838

E 1/4 Cor. Sec. 11, Fnd.  $\frac{5}{8}''$  rebar in Mon. Box. Set by Lagier in 1976 Sur. for Meyer.

22-52-A