


NARRATIVE:

THE PURPOSE OF THIS SURVEY IS TO STAKE THE CORNERS OF A BLOCK OF LAND DESCRIBED AS LOTS 1 THROUGH 25 "OLYMPIC PARK SUBDIVISION" STANFIELD, OREGON, FOR A PENDING SALE.

"OLYMPIC PARK" WAS SURVEYED IN 1911 AND I COULD FIND NO METAL MONUMENTS AT THE LOT CORNERS. IT WAS A REPLAT OF LOTS 1 THROUGH 7 AND LOTS 156 THROUGH 165 OF "STANFIELD ORCHARD OUTLOTS". I HAVE DONE SEVERAL SURVEYS IN "STANFIELD ORCHARD OUTLOTS" IN THIS AREA AND RETRACED CORNERS FROM THEM TO ESTABLISH THE CORNERS OF "OLYMPIC PARK". KRUMBEIN DID A SURVEY ON A PORTION OF THESE LOTS IN A 1977 SURVEY FOR McFADDEN BUT I DID NOT USE HIS MONUMENT AT THE NORTHWEST CORNER OF LOT ONE.

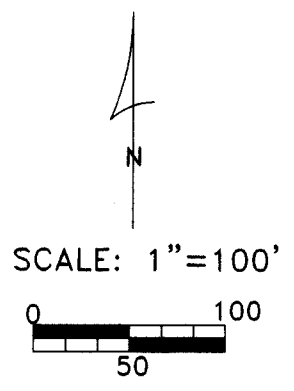

REGISTERED
 PROFESSIONAL
 LAND SURVEYOR

G. Dennis Edwards

OREGON
 JULY 16, 1971
 G. DENNIS EDWARDS
 9 5 1
 RENEWS 12/31/2001

CURVE TABLE

#	RADIUS	Δ	LENGTH	CHORD
C1	90.00'	90°40'59"	142.45'	S 44°51'27" W 128.04'
C2	130.00'	90°40'59"	205.75'	S 44°51'27" W 184.94'
C3	238.04'	47°36'01"	197.76'	S 24°22'09" E 192.12'

RECEIVED BY
 Umatilla County Surveyor
 Date 12-00
 Rec'd by KE
 No. 00-260-A

SURVEY FOR ASSOC. RELOCATION MANAGEMENT CO. INC. & LOREN MAHER
 IN LOTS 1 THROUGH 25, "OLYMPIC PARK SUBDIVISION",
 IN SE 1/4, SEC. 32, T 4 N, R 29 E, W.M.,
 CITY OF STANFIELD, UMATILLA COUNTY, OREGON
 9/12/2000 REVISED 12/5/2000 JOB# S0009184
 EDWARDS SURVEYING P.O. BOX 763
 541-567-3336 HERMISTON, OREGON 97838
 DRAWN BY NJF

FND. 2 1/2" B.C. PRE 1974

FND. 1/2" IRON REBAR ORIGIN UNKNOWN

FND. 5/8" IRON REBAR FOR RAUCH

FND. 2 1/2" B.C. KRUMBEIN 1974

FND. 2 1/2" B.C. USED HADDOCK SET IN 1998 OVER KIMBRELL IRON PIPE B. 2, P. 263

FND. 5/8" WITH 2" ALUM. CAP SET BY ME FROM MONUMENT IN COE'S ADD. 1995. THIS ONE WOULD ALSO FIT OLYMPIC PARK BETTER. DID NOT USE

00-260-A