

NARRATIVE:

THE PURPOSE OF THIS SURVEY IS TO SET THE CORNERS BETWEEN LOTS 21 & 22, "HAYDEN RIVER ESTATES", TO SEE WHERE A WOOD FENCE LIES IN RELATION TO THE LOT LINE.

REGISTERED
 PROFESSIONAL
 LAND SURVEYOR

G. Dennis Edwards

OREGON
 JULY 16, 1971
 G. DENNIS EDWARDS
 9 5 1
 RENEWS 12/31/2003



RECEIVED BY

Umatilla County Surveyor

Date 2-03

Rec'd By KK

No. 03-14-A

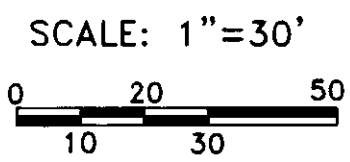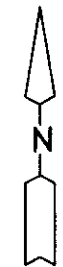

LEGEND:

- FOUND 5/8" IRON REBAR, PLAT OF "HAYDEN RIVER ESTATES", CUMMINGS 1998
- SET 5/8"x30" IRON REBAR WITH PLASTIC CAP #951

SURVEY FOR GARY WEBB
 IN LOT 21 & 22, "HAYDEN RIVER ESTATES",
 IN NE 1/4, SEC. 19, T 5 N, R 28 E, W.M.,
 CITY OF UMATILLA, UMATILLA COUNTY, OREGON
 10/31/2002 JOB# S0210220
 EDWARDS SURVEYING P.O. BOX 763
 541-567-3336 HERMISTON, OREGON 97838
 DRAWN BY NJF

03-14-A