

NARRATIVE:

THE PURPOSE OF THIS SURVEY IS TO STAKE THE NE CORNER OF BLOCK 12 "BROWNELL'S ADDITION" SO A FENCE CAN BE BUILT.


I SURVEYED PART OF THE SOUTH LINE OF SAID BLOCK 12 IN A 1989 SURVEY FOR THE UMATILLA SCHOOL DISTRICT AND ALSO SURVEYED THE WESTERLY PORTION OF THE SOUTH LINE IN A 2001 SURVEY FOR GARCIA AND GROW. I ESTABLISHED THE NE CORNER OF BLOCK 12 BY RETRACING CRIGER'S 1944 SURVEY OF SAID "BROWNELL'S ADDITION".

REGISTERED PROFESSIONAL LAND SURVEYOR

G. Dennis Edwards

OREGON
JULY 16, 1971
G. DENNIS EDWARDS
9 5 1
RENEWS 12/31/2003

- LEGEND:**
- MONUMENTS FOUND AS NOTED
 - SET 5/8"X30" IRON REBAR WITH PLASTIC CAP #951
 - (000) OF RECORD, PLAT OF "BROWNELL'S ADDITION"
 - (000)E OF RECORD, MY 1989 SURVEY FOR UMATILLA SCHOOL DISTRICT

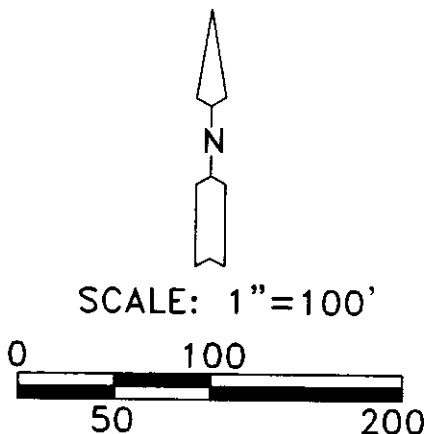

RECEIVED BY
Umatilla County Surveyor
Date 7-03
Rec'd By KR
No. 03-109-A

SURVEY FOR REBECCA GARCIA
IN BLK. 12, "BROWNELL'S ADDITION" TO CITY OF UMATILLA,
IN NE 1/4, SEC. 17, T 5 N, R 28 E, W.M.,
UMATILLA COUNTY, OREGON
5/13/2003 JOB# S0105110B
EDWARDS SURVEYING P.O. BOX 763
541-567-3336 HERMISTON, OREGON 97838
DRAWN BY NJF

03-109-A