

Mon & SW 11th

Record Dist: $\frac{1}{2}$ Main to Mon SW 11th 2870.00
 City Measure: 2870.30

K = 1.000 - 1045


S 66-24-18 W 790.08

SE ISAAC


EC

Iron Pin


Iron Pin

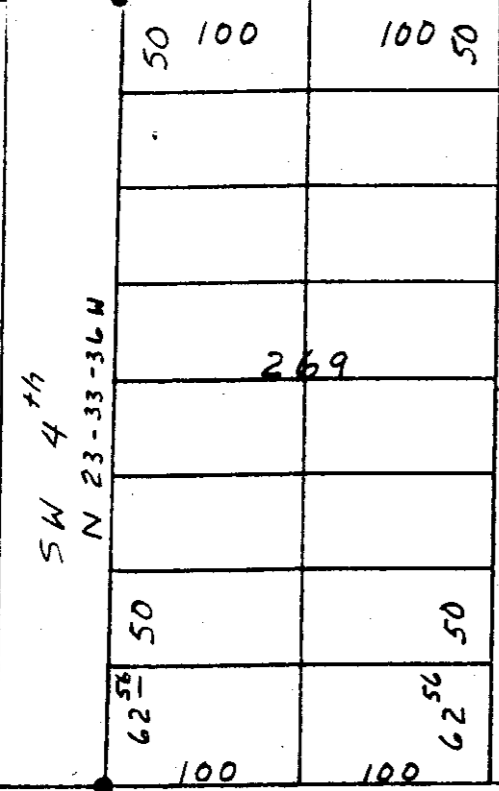


269

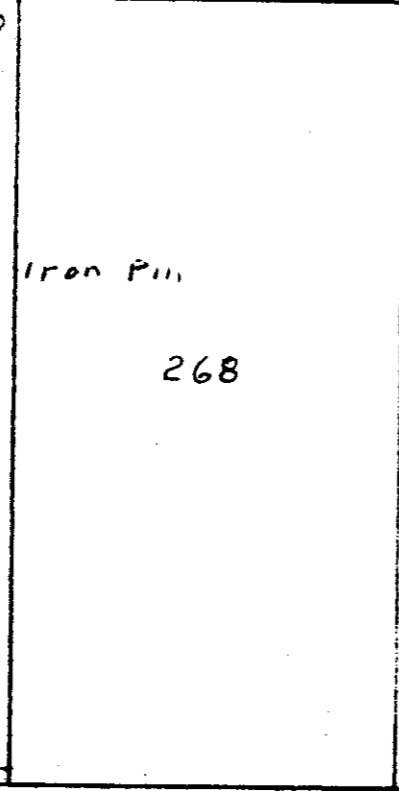


268

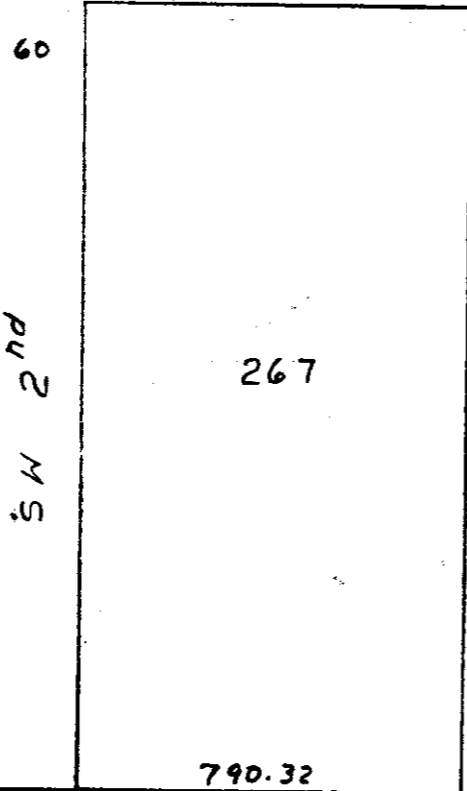

267

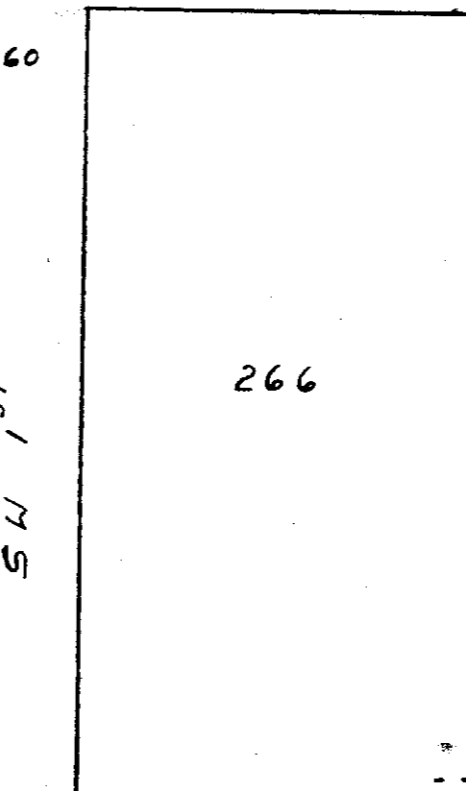

266

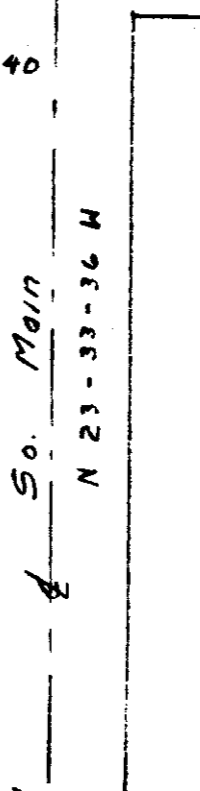

So. Main

N 23-33-36 W

EC

Record Dist: Mon #9 - Mon #7: 2145.00
 City Meas: " " 2145.86
 K = 1.000 - 4009

Narrative: Monuments on South Main Street & on SW 11th & Isaac were used as control. Distances based on these monuments were measured & compared with distances of record; equations were computed. Distances shown and points set were based on these distances. Angles were turned based on bearings shown.

03-146-A

| | |
|--------------------------------------|------------------------|
| WAYNE HARRIS CO. INC. | |
| SURVEY FOR: LLOYD RALSTON | |
| LOCATION: BLOCK 269 RESERVATION ADD. | |
| DATE 7-23-85 | CHECK BY <u>wjh</u> |
| SCALE 1"=100' | FILE <u>1706</u> |
| DRN BY <u>wjh</u> | JOB _____ |
| | DRNG NO. <u>96-12A</u> |

2N 32 11 CB

03-146-A