

NARRATIVE:

THE PURPOSE OF THIS SURVEY IS TO DO A BOUNDARY LINE ADJUSTMENT BETWEEN LOTS 6 AND 7 "CONNER TRACTS" FOR A PENDING SALE SO A MOBILE HOME WILL NOT ENCROACH.

I BASED THE BEARINGS AND THIS SURVEY ON ONE I DID IN APRIL 2004 FOR FLINK.

REGISTERED
PROFESSIONAL
LAND SURVEYOR

G. Dennis Edwards


OREGON
JULY 16, 1971
G. DENNIS EDWARDS
9 5 1
RENEWS 12/31/2005

LEGEND:

- FOUND 5/8" IRON REBAR SET BY ME IN APRIL 2004 SURVEY FOR FLINK, UNLESS NOTED OTHERWISE
- SET 5/8"X30" IRON REBAR WITH PLASTIC CAP #951
- ⊙ COMPUTED FROM PLAT OF "CONNER TRACTS"
- (000) OF RECORD, PLAT OF "CONNER TRACTS"

CURVE TABLE

| # | RADIUS | ARC | CHORD | DELTA |
|----|----------|-------------------|-----------------------|----------|
| C3 | 1175.92' | 155.65' (155.22') | N 19°38'20" W 155.54' | 7°35'02" |
| C4 | 1175.92' | 41.72' (42.00') | N 14°49'49" W 41.72' | 2°01'59" |

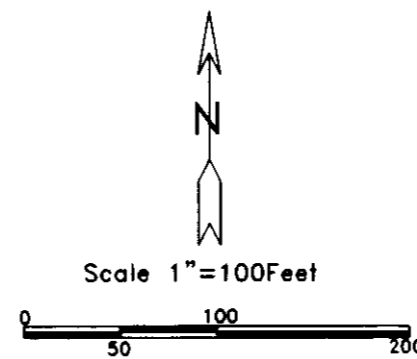

SURVEY FOR JOANNE FLINK
IN LOTS 6 & 7, "CONNER TRACTS" IN
SE 1/4, SEC. 33, T 5 N, R 28 E, W.M.,
UMATILLA COUNTY, OREGON
6/28/2004 JOB# S0403055A
EDWARDS SURVEYING P.O. BOX 763
541-567-3336 HERMISTON, OREGON 97838
DRAWN BY NJF

RECEIVED BY _____

Umatilla County Surveyor

Date 8-04

Rec'd By KK

No. 04-144-A