


Plat Showing Block 124 and the location
of "Veterans of Foreign Wars" Building
of Pendleton, Oregon.
Dec. 1934. Scale 1"=50 Ft.

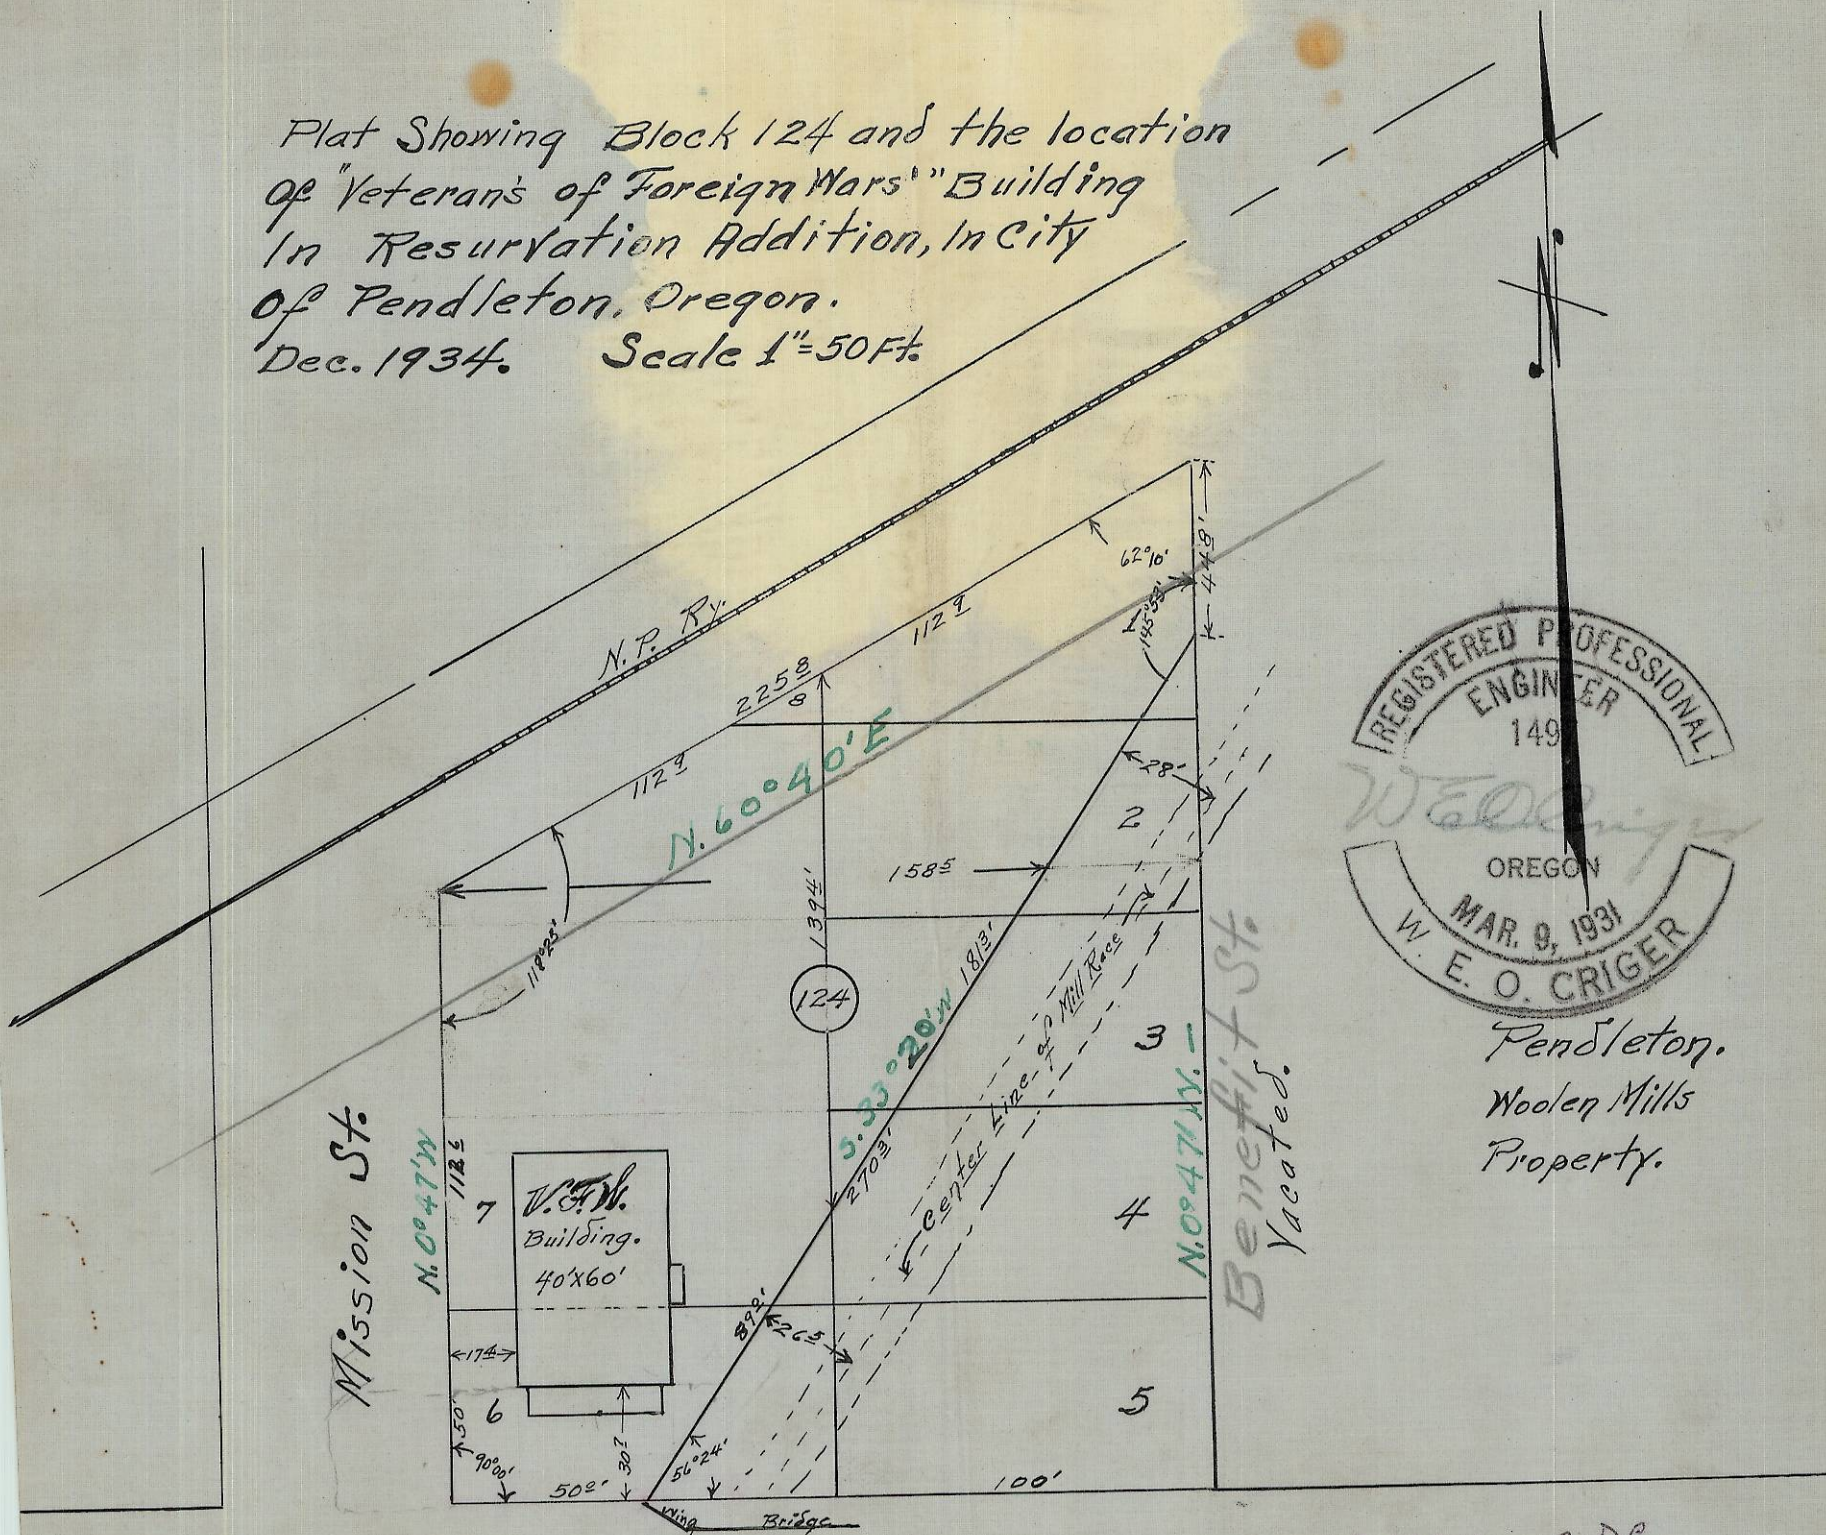

Pendleton.
Woolen Mills
Property.

E. Court Street

2N32 2DC

06-285-A