




LEGEND

- - - - - SET IRON PINS
- SHADED - - - - DEEDED PROPERTY
- HATCHED - - - - LEASED PROPERTY

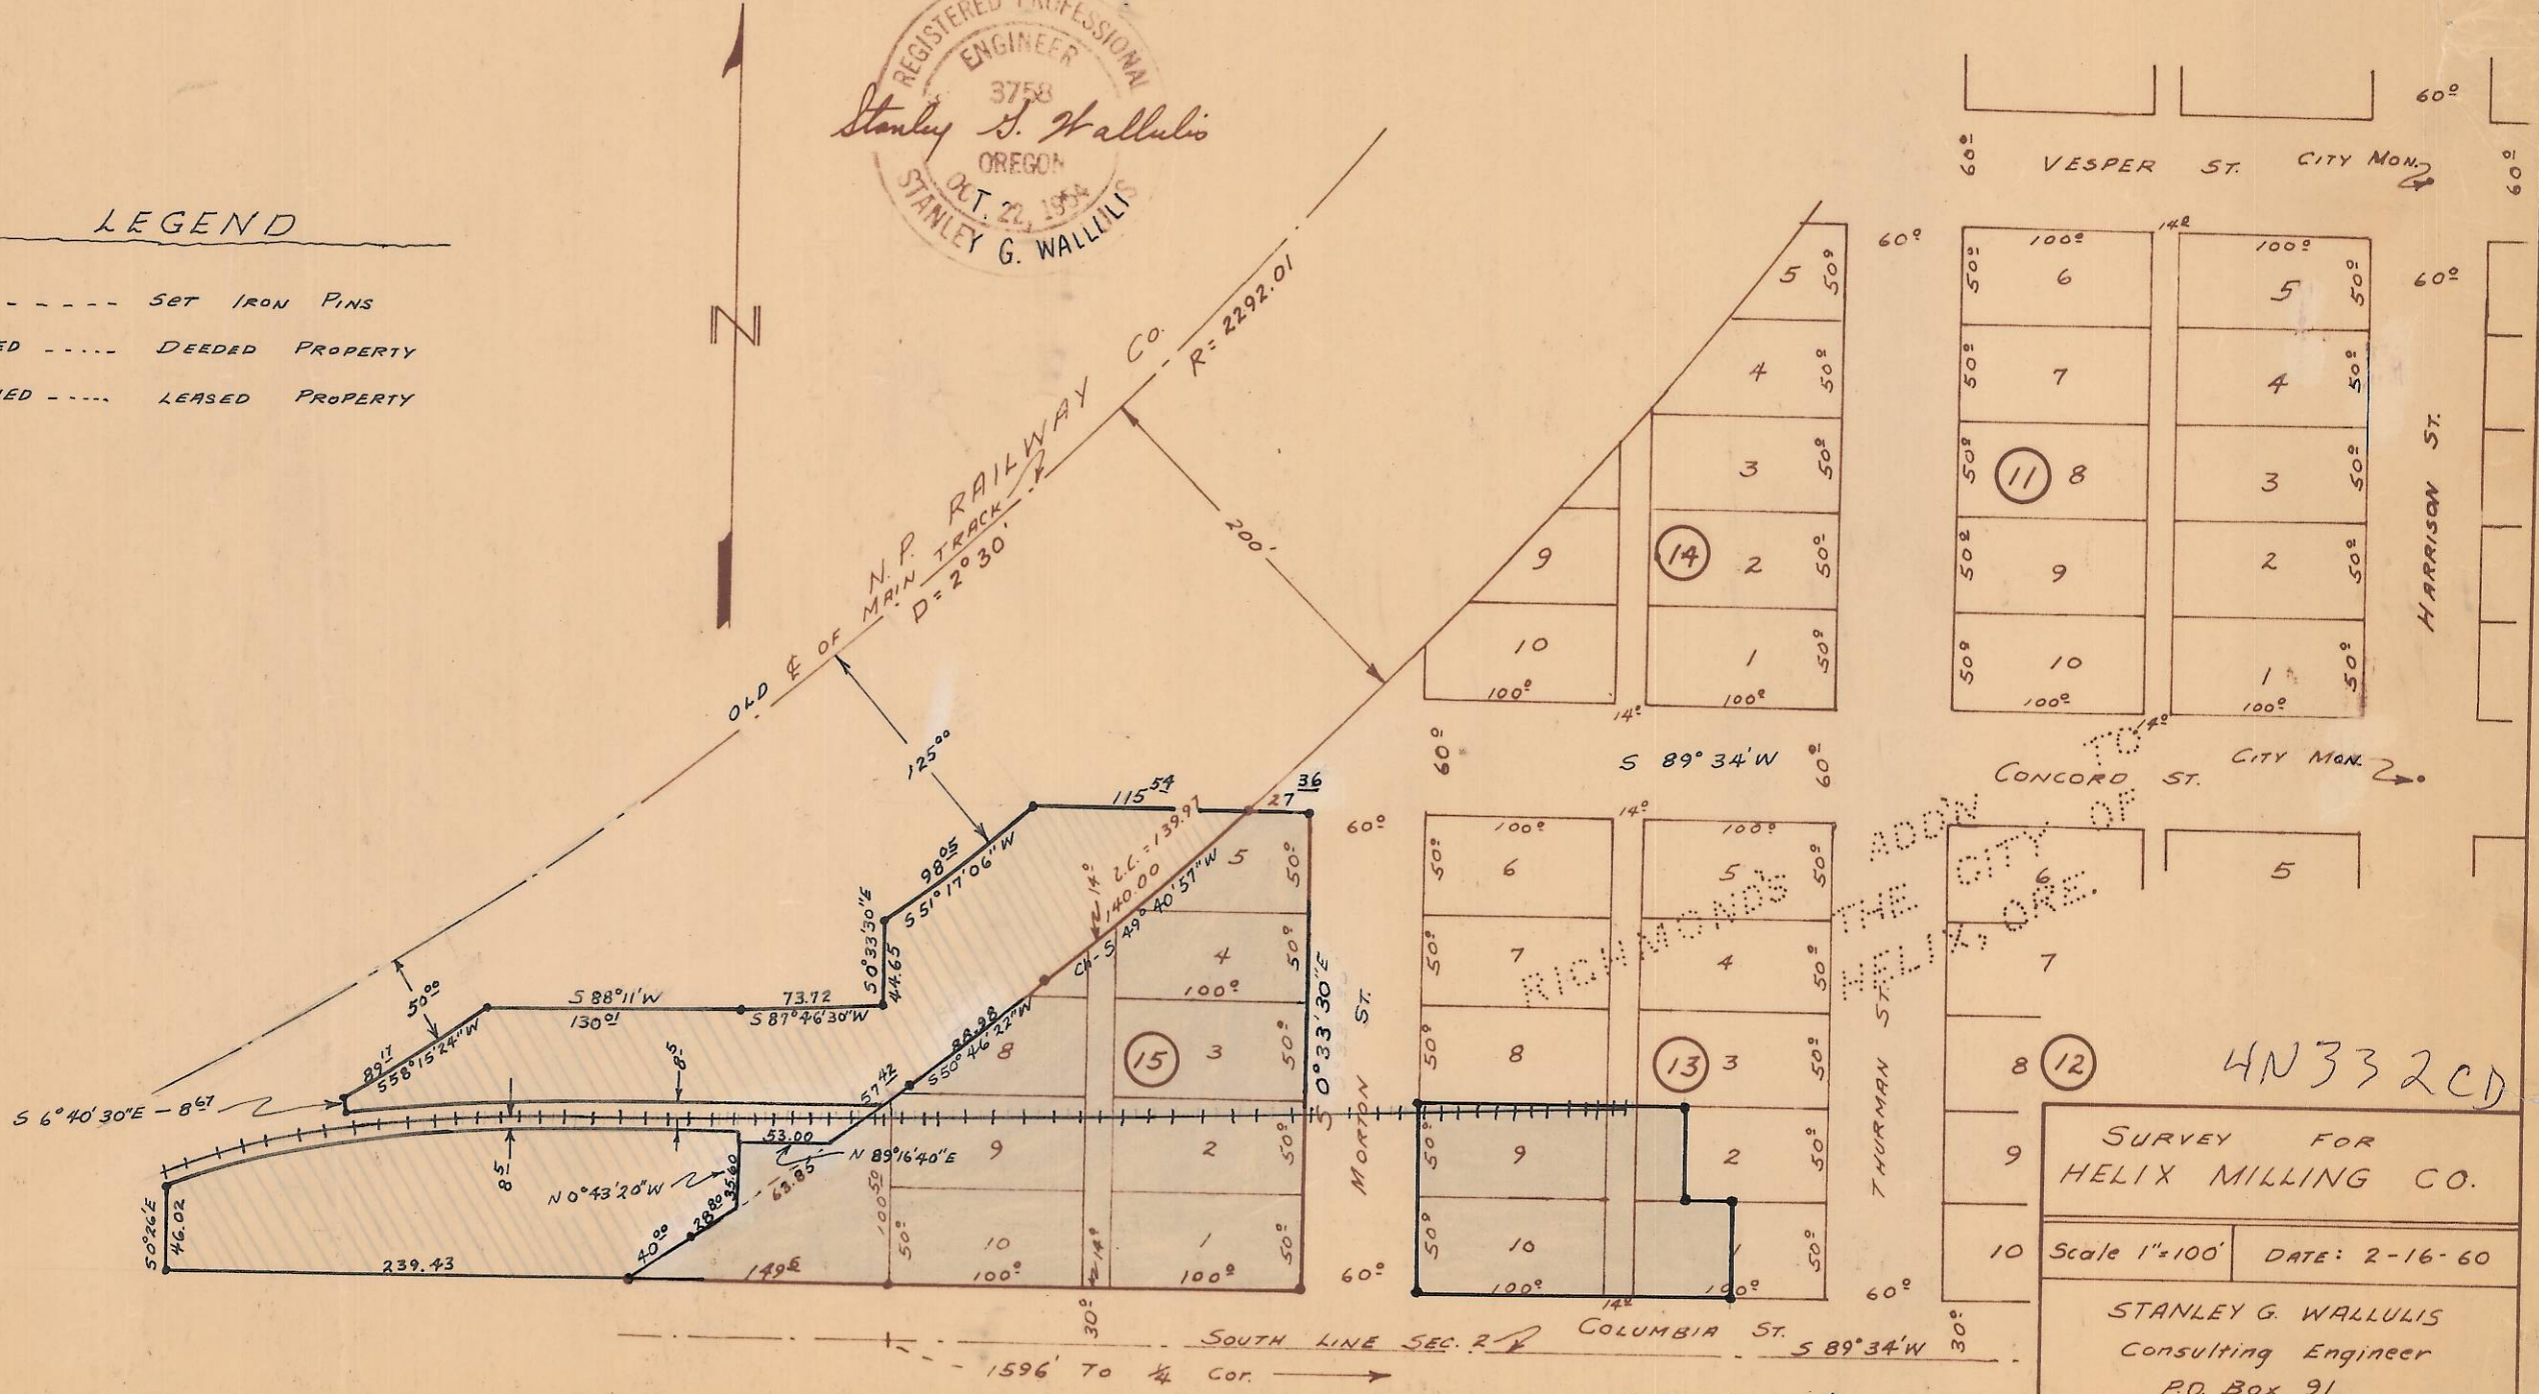


4N332CD

SURVEY FOR
 HELIX MILLING CO.

Scale 1"=100' DATE: 2-16-60

STANLEY G. WALLULIS
 Consulting Engineer
 P.O. Box 91
 PENDLETON OREGON

06-432-A