


T6 N.R.35 E.W.M.

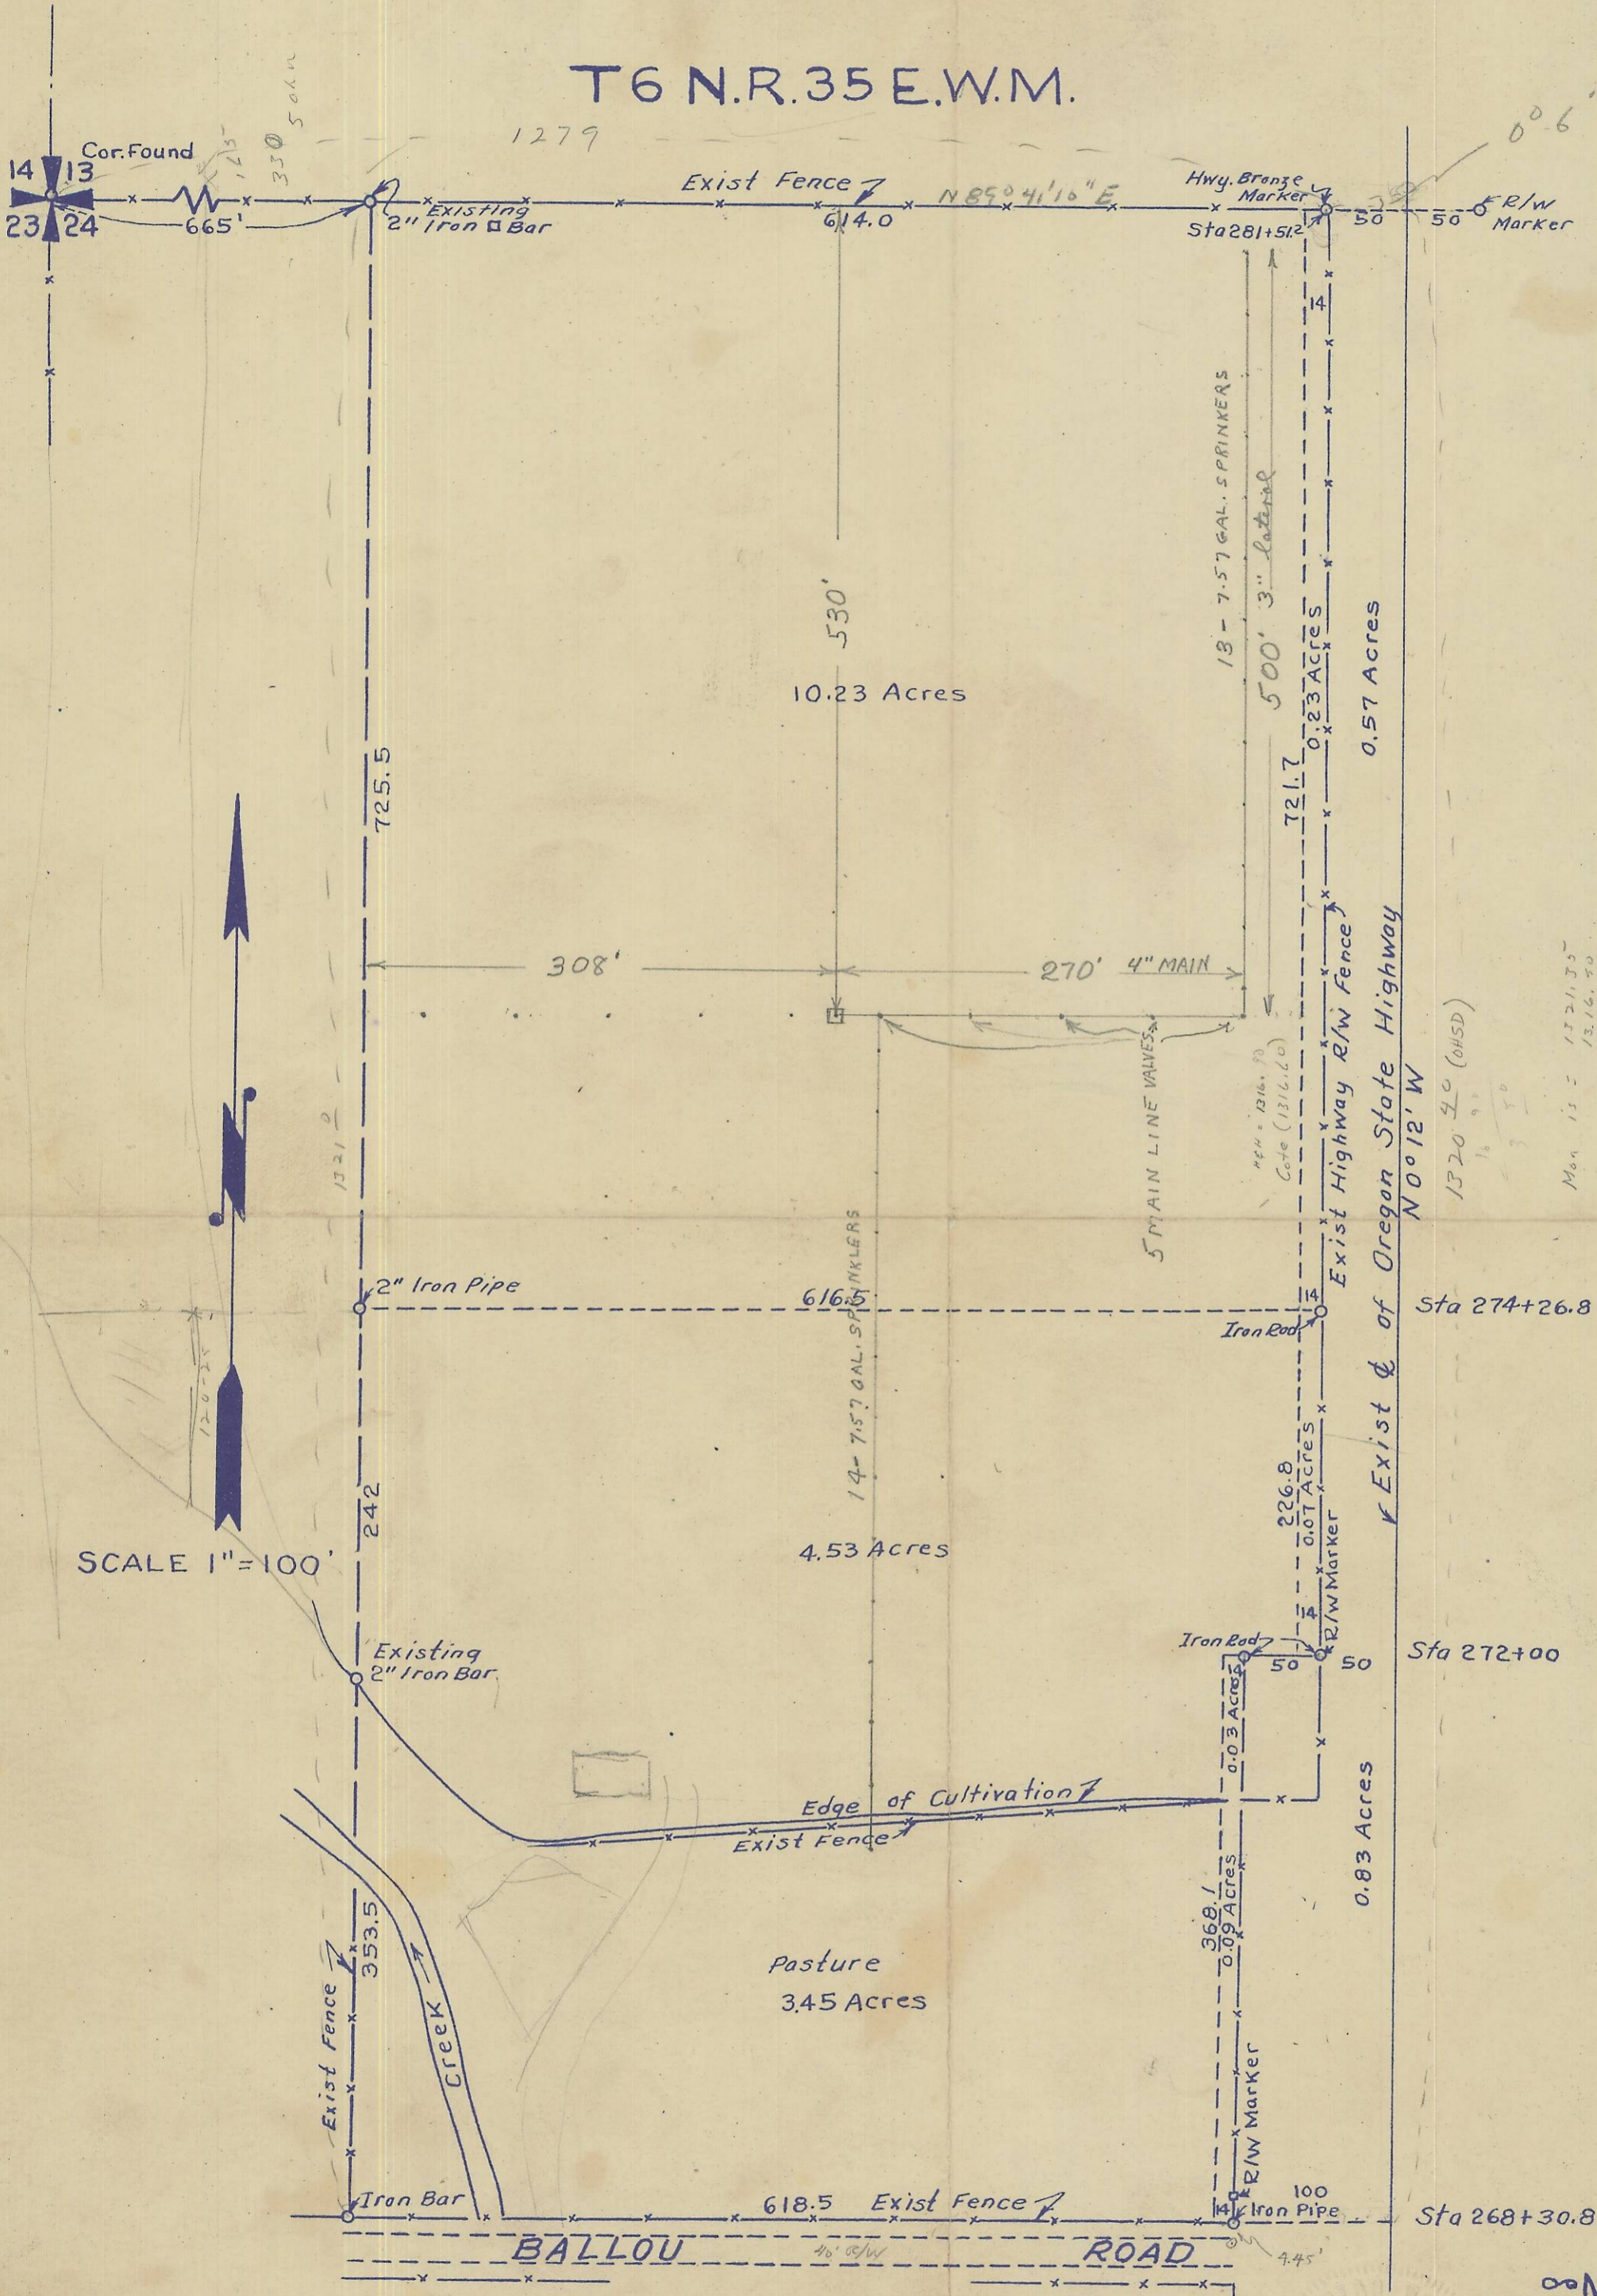

SCALE 1"=100'

MAP OF  
 E 1/2 NW 1/4 NW 1/4  
 SEC. 24-6-35  
 APRIL 19, 1953  
 Clinton W. Cote  
 CIVIL ENGR.

06-583-A

268.308  
 368.1  
 2719.39

7217  
 2648  
 998.5  
 2084808  
 368.1  
 2714819

10.23  
 4.53  
 0.83  
 0.23  
 0.57

266.8  
 721.7  
 368.1  
 131.515

Mon 13 = 1321.35  
 1316.50  
 4.45' short of 1/16 Line

1320.50 (OHSD)