


For Jack White

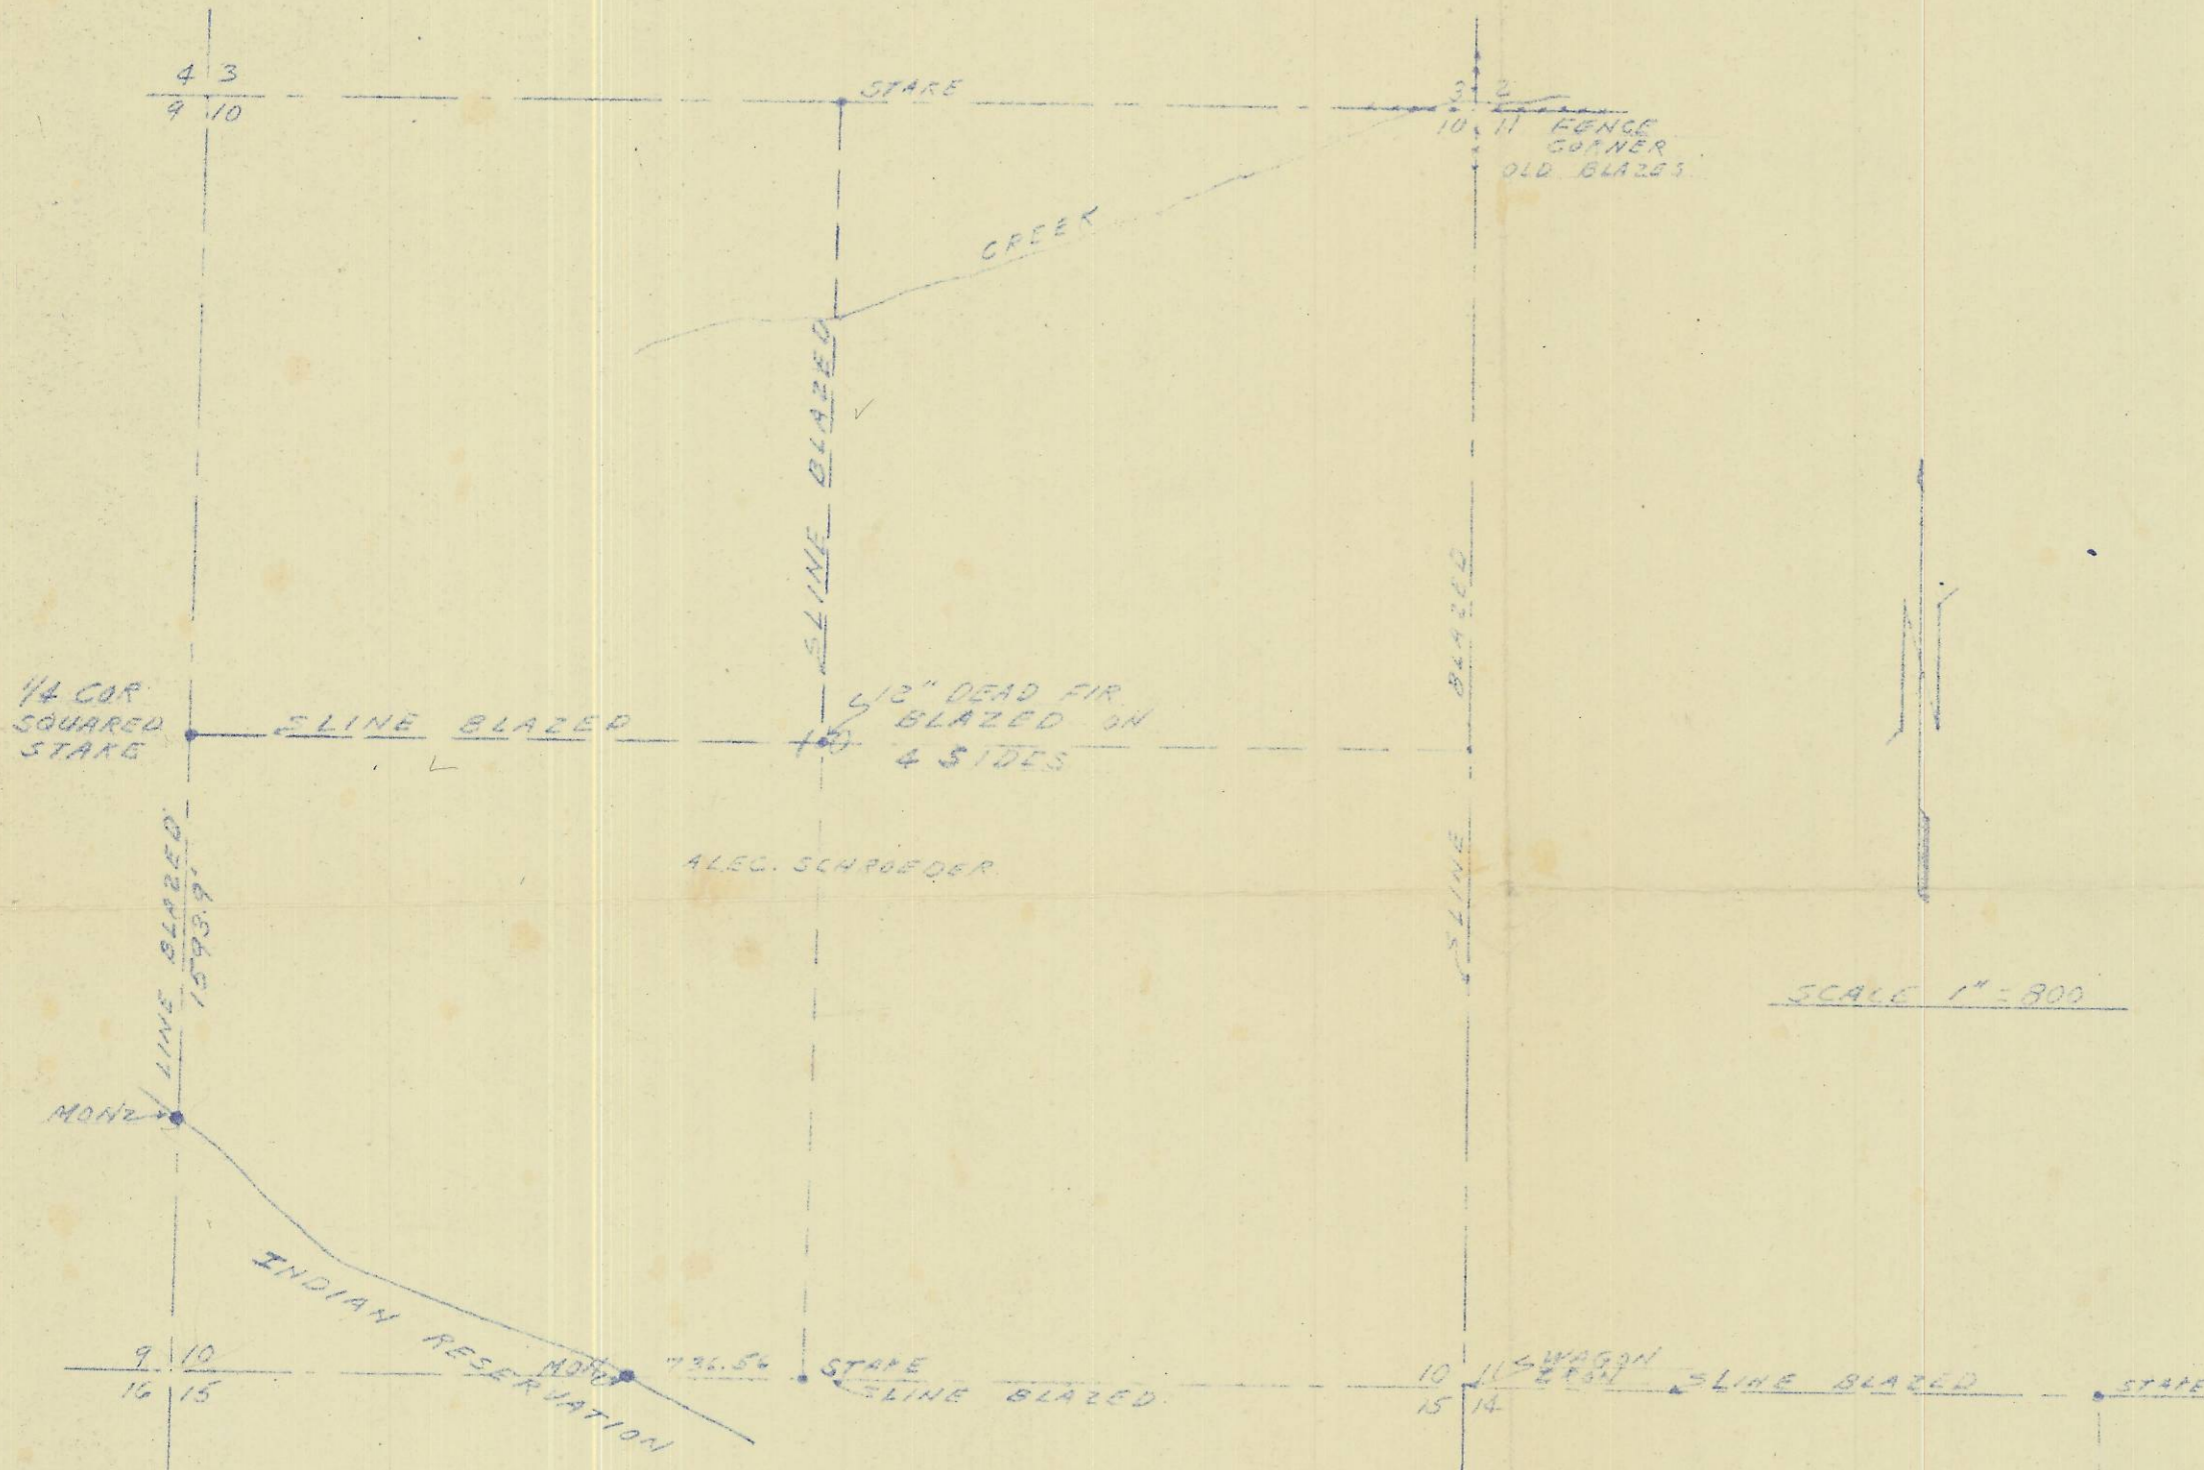

SCALE 1" = 800

REGISTERED
OREGON
 LAND SURVEYOR

G. M. Newbill

MAY 6, 1948
G. M. NEWBILL
 255

G. M. NEWBILL

LICENSED LAND SURVEYOR

17 N. Second Walla Walla, Wash. Phone 4170

| | | |
|---------------|-----------------------------|----------|
| Surveys | A SURVEY | |
| Descriptions | FOR TUNISON & WILSON | |
| Sub Divisions | SEC 10 & 14 - T. 3N. R. 36E | |
| Date | 6/27/55 | No. 1685 |
| Drawn By | G.M.N. | |
| Checked By | | |

06-587-A