


# Fruit Vale Smitten vs. Swash Survey Sept. 17, 13. Scale. 400' = 1"

Sec 21 T6 N R 35 E W M

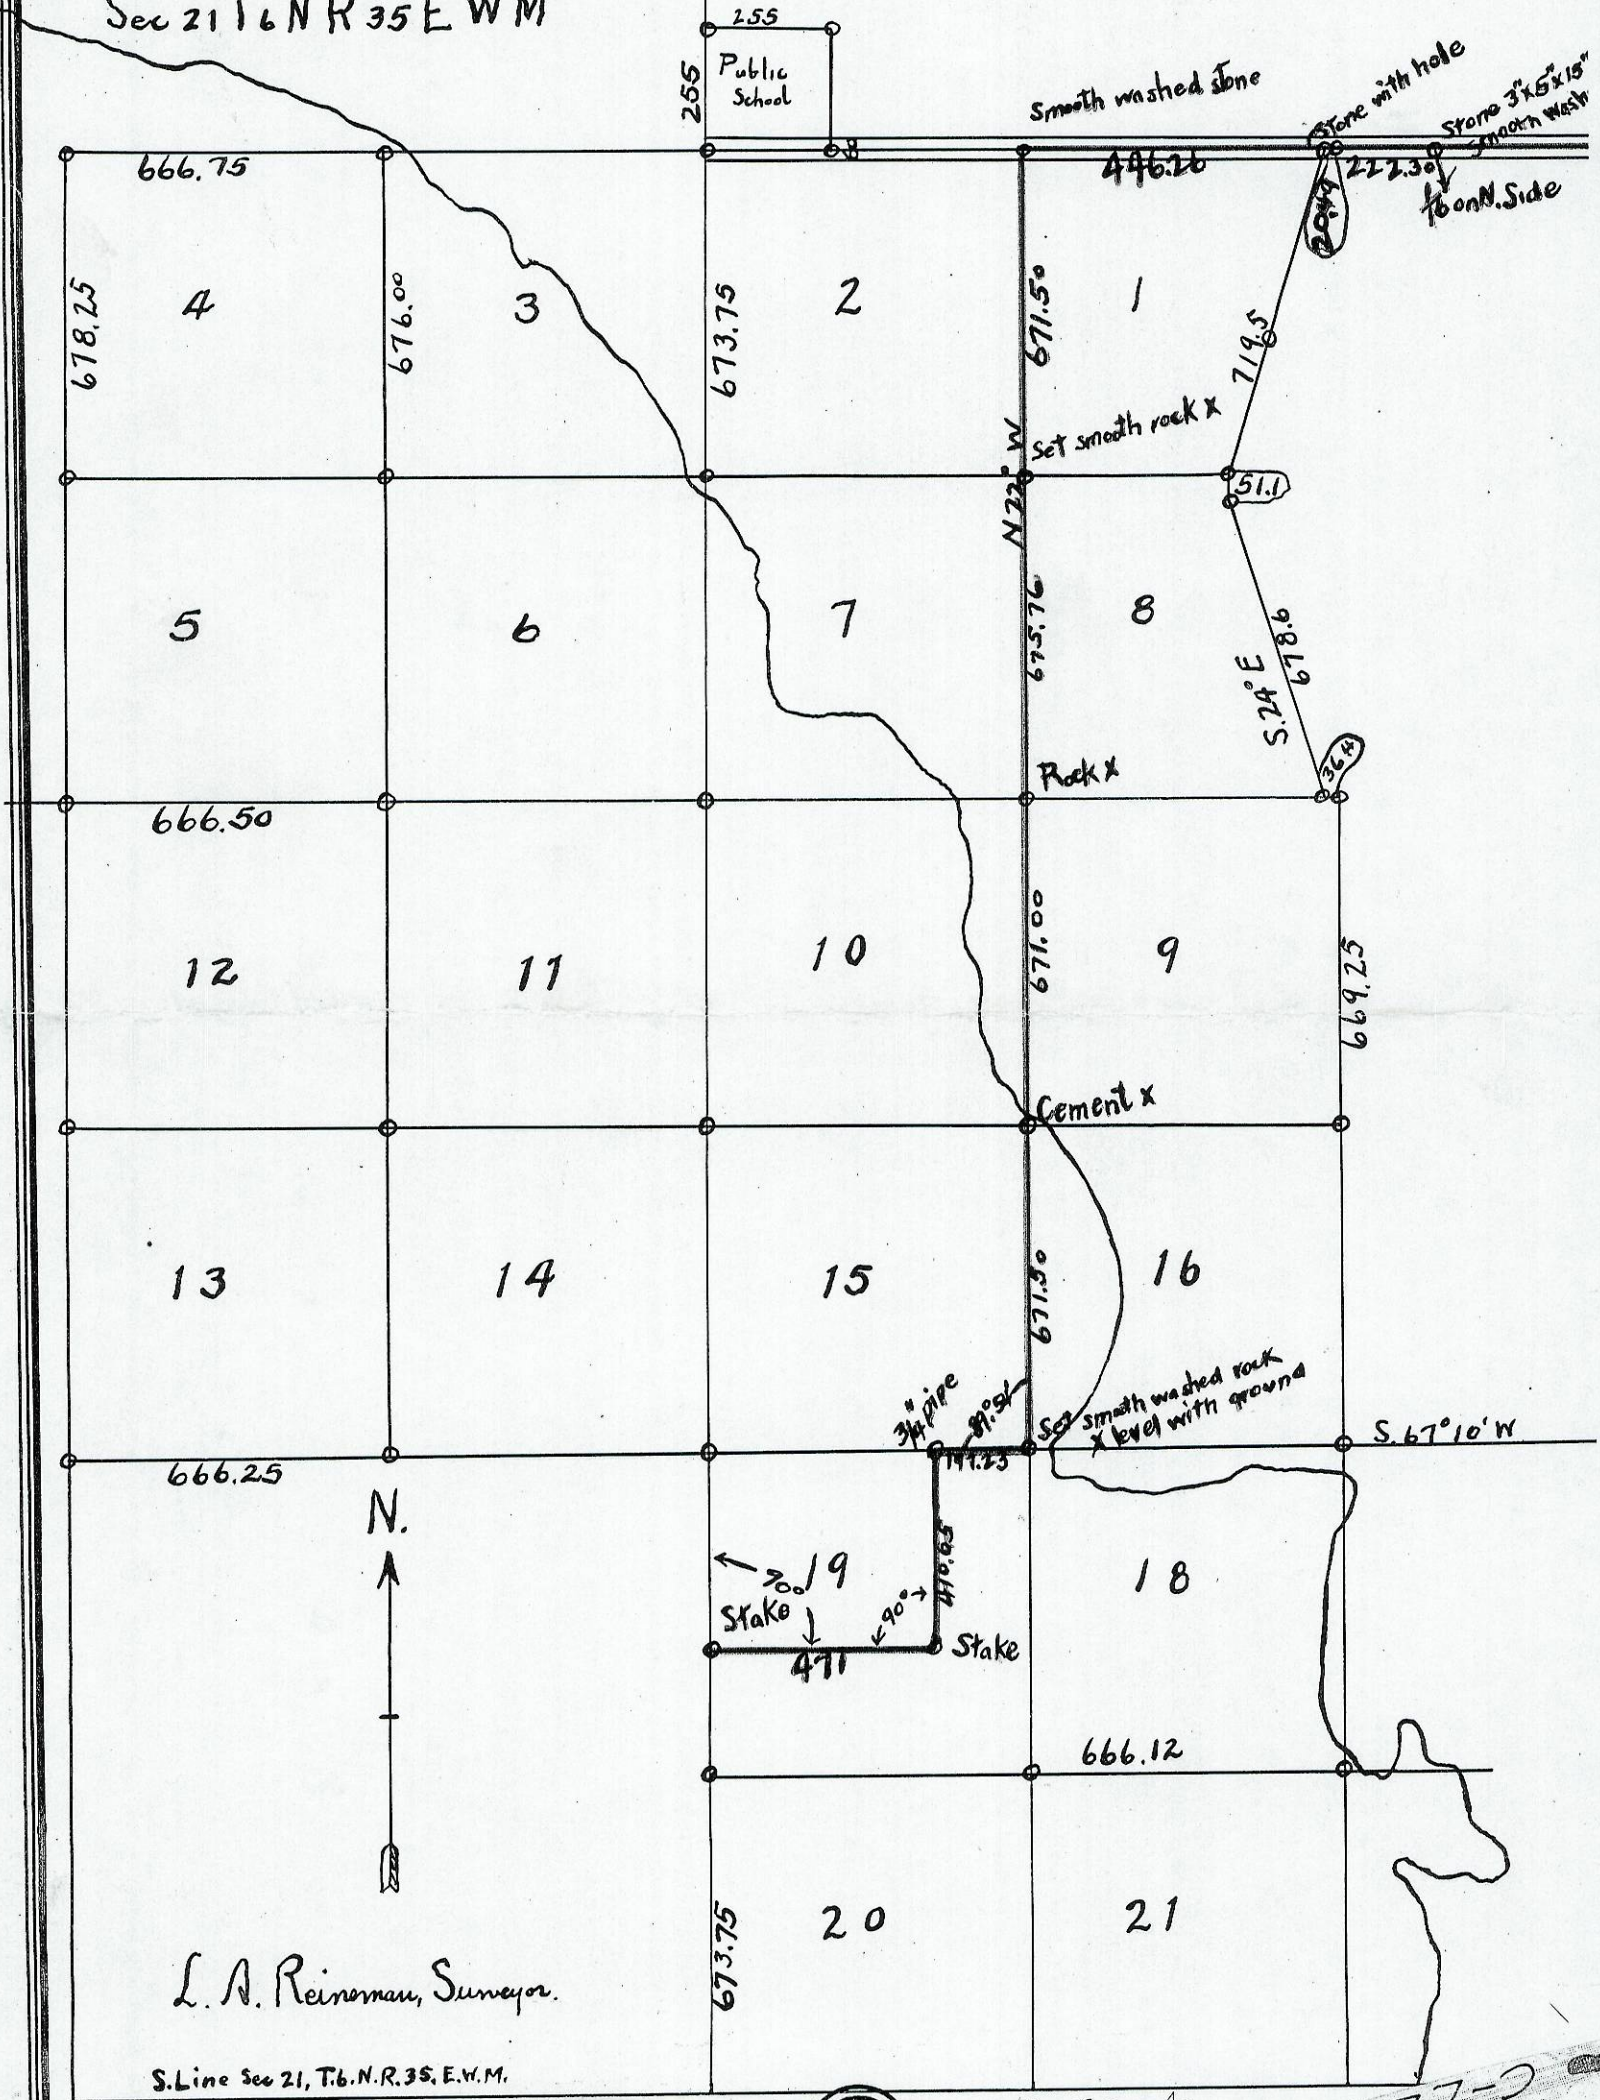

L. A. Reinerman, Surveyor.

S. Line Sec 21, T. 6. N. R. 35, E. W. M.

07-32-A Ho- 27-C