


Umatilla County Surveyor
 Date 01-07
 Drawn by KK
 No. 09-03

NARRATIVE:

THE PURPOSE OF THIS SURVEY IS TO STAKE THE FOUR CORNERS OF THE TOTAL PROPERTY DESCRIBED IN DEEDS TO KIM WILLIAMS RECORDED ON INSTRUMENTS 2008-514036 AND 2008-5410537 UMATILLA COUNTY DEED RECORDS TO SEE HOW THE FENCES MATCH THE DEED LINES.

DAVE KRUMBEIN SURVEYED THE NORTH EAST AND WEST LINES IN A 1972, REV. 1975 SURVEY FOR BENSEL. I FOUND THREE OF HIS FOUR MONUMENTS OF THE SE 1/4 OF THE NE 1/4 OF SEC. 27.

I USED A TOPCON HIPER + G.P.S. TO CONDUCT THIS SURVEY AND BASED THE BEARINGS ON MY PARTITION PLAT 2008-20 IN SECTION 26.

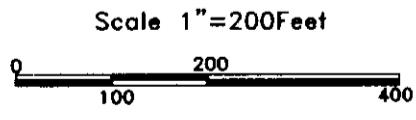

LEGEND:

- FND. 5/8" I. REBAR, ME 2000 SUR. FOR NORTHROP. THERE IS A 1" I. BAR LYING 0.7' N & 2.9' W. ORIG. UNKNOWN
- ⊕ FOUND 2 1/2" B.C. KRUMBEIN 1972 SURVEY FOR BENSEL
- SET 5/8"X30" IRON REBAR WITH PLASTIC CAP #951
- ⊙ COMPUTED LOCATION
- (000) OF RECORD, 1972, REV. 1975 KRUMBEIN SUR. FOR BENSEL

REGISTERED
 PROFESSIONAL
 LAND SURVEYOR

G. Dennis Edwards

OREGON
 JULY 16, 1971
 G. DENNIS EDWARDS
 9 5 1
 RENEWS 12/31/2009

SURVEY FOR KIM WILLIAMS
 IN SE 1/4, NE 1/4, SEC. 27, T 5 N,
 R 28 E, W.M., UMATILLA COUNTY, OREGON
 10/15/2008 JOB# S0810128
 EDWARDS SURVEYING P.O. BOX 763
 541-567-3336 HERMISTON, OREGON 97838
 DRAWN BY JMC