


Section 2 T5N. R35E.W.M.

These distances except on the east line are according to J.W. Kimbrell's test of my Survey Feb. 21, 1898.

L.A. Wilson  
surveyor.

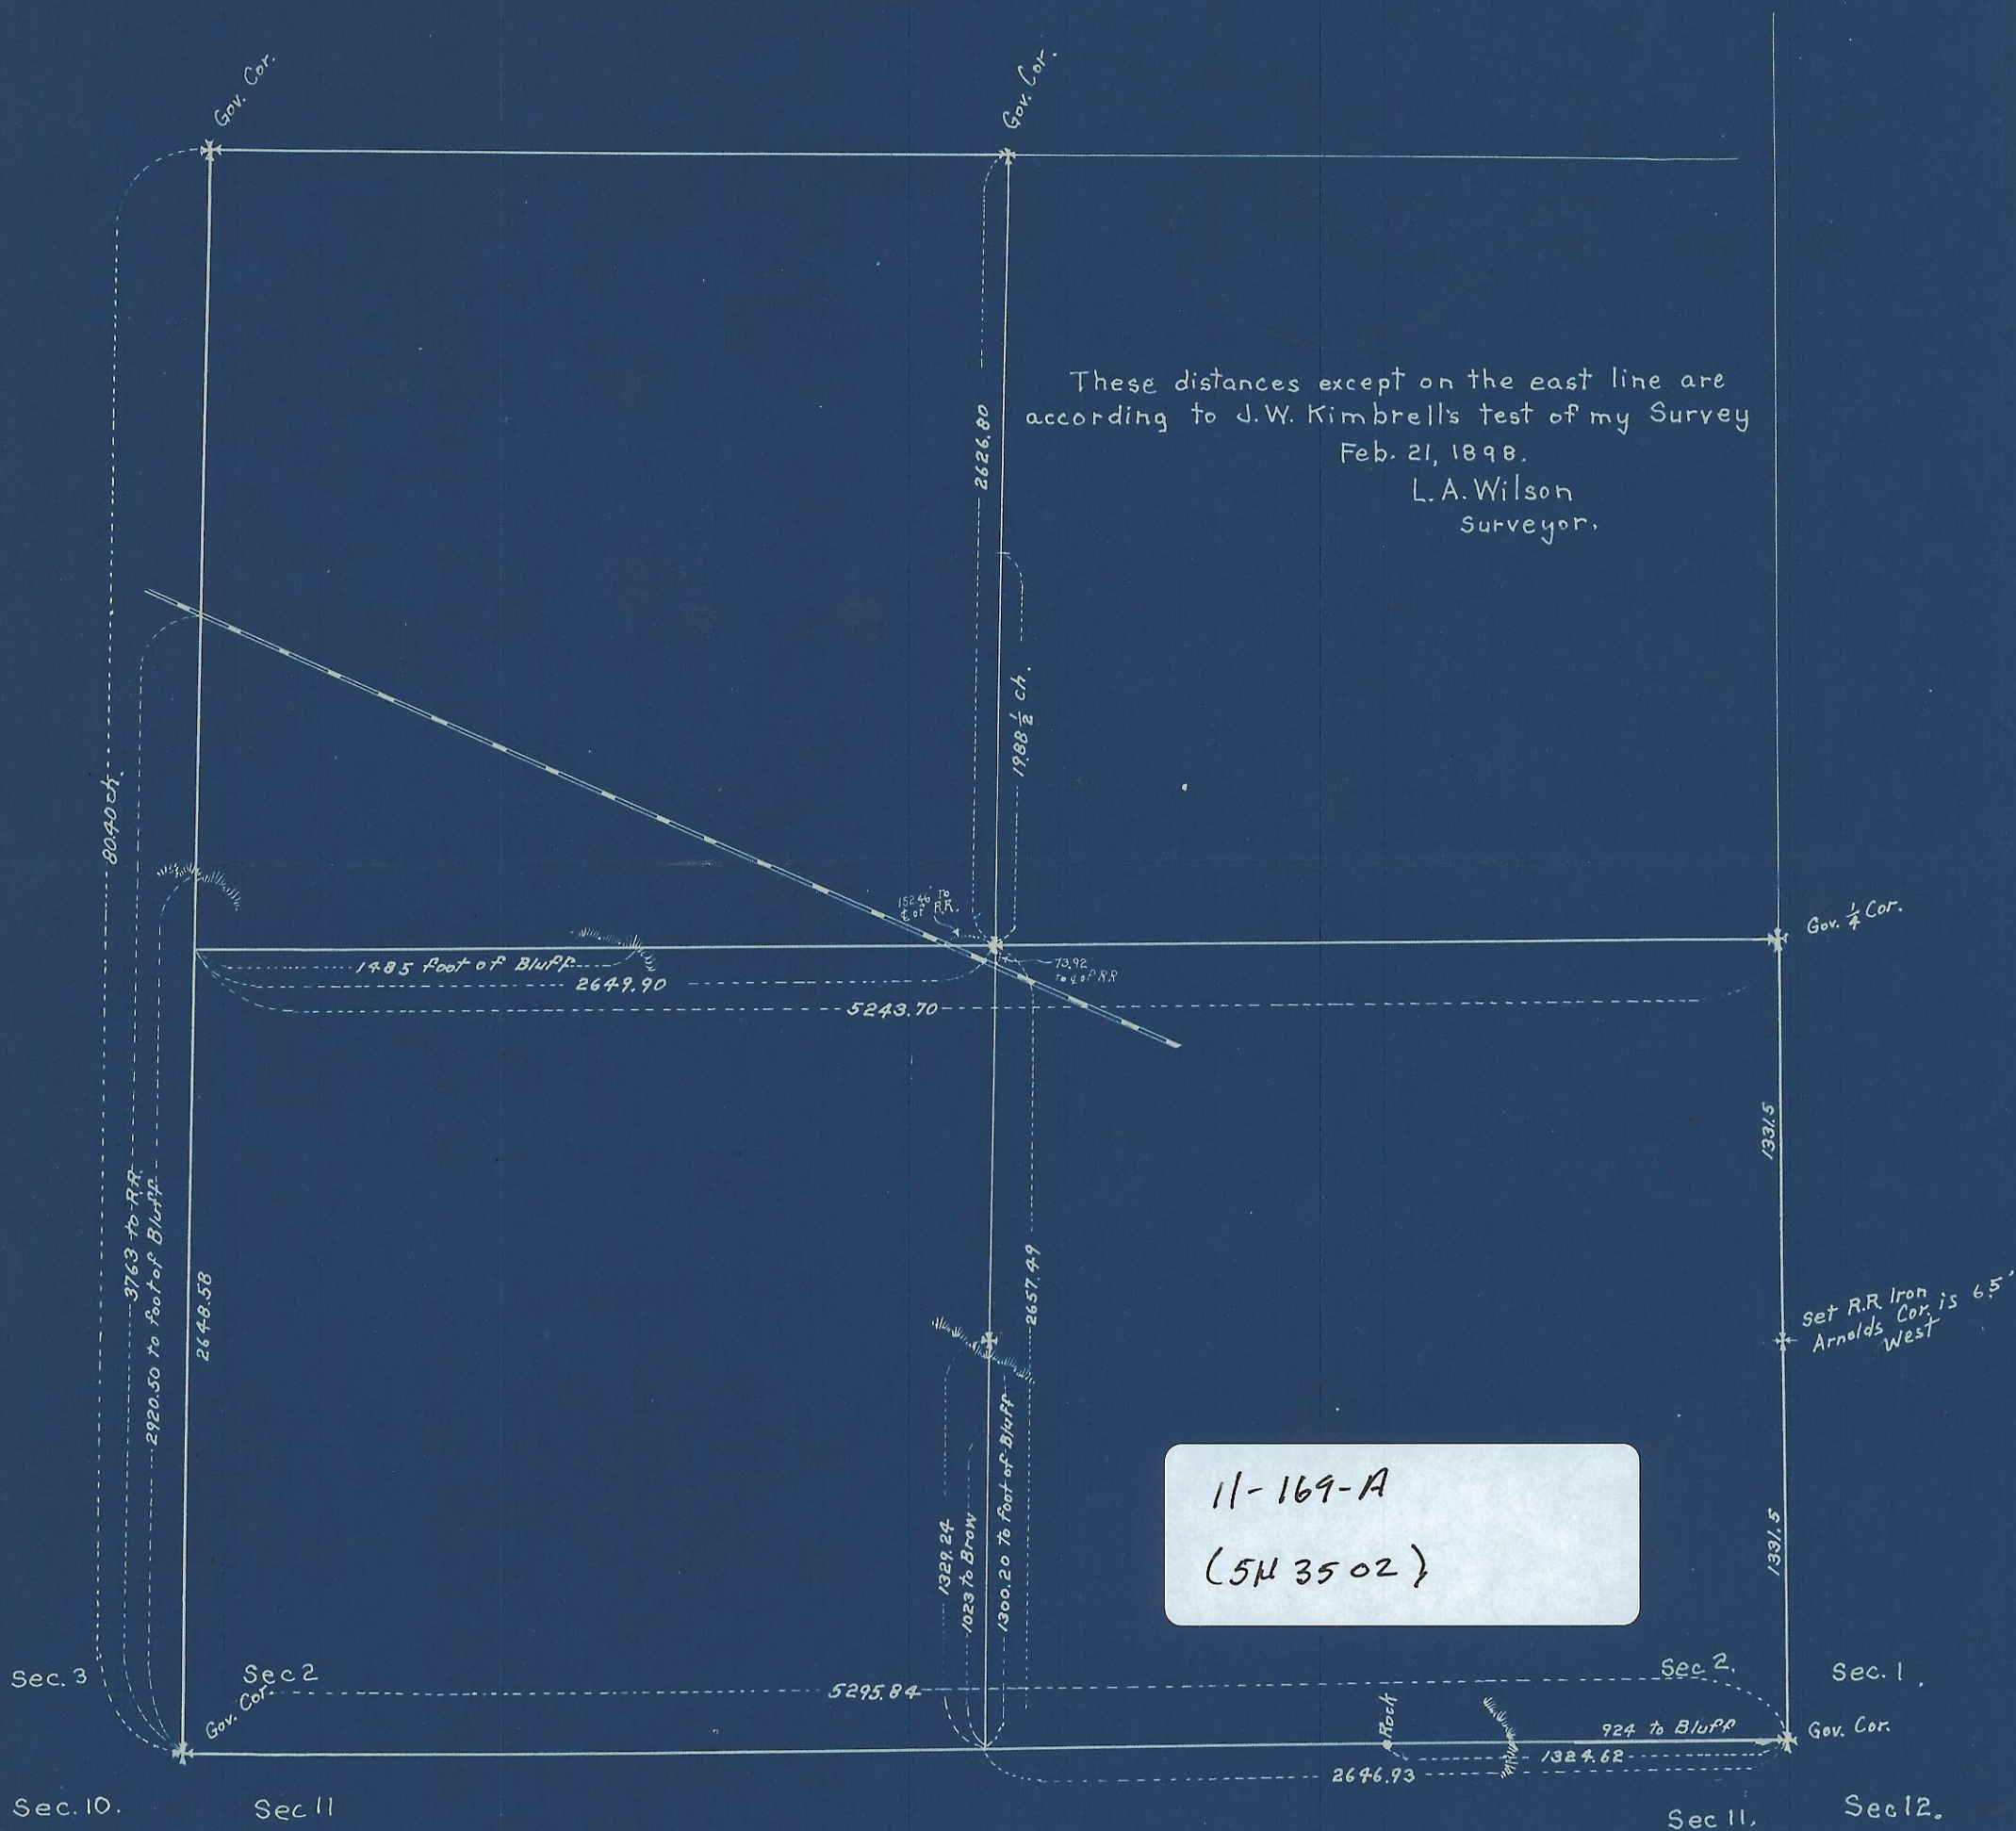

11-169-A  
(5M 3502)