Sec. 15, T. 5 N., R. 29 E., W. M.

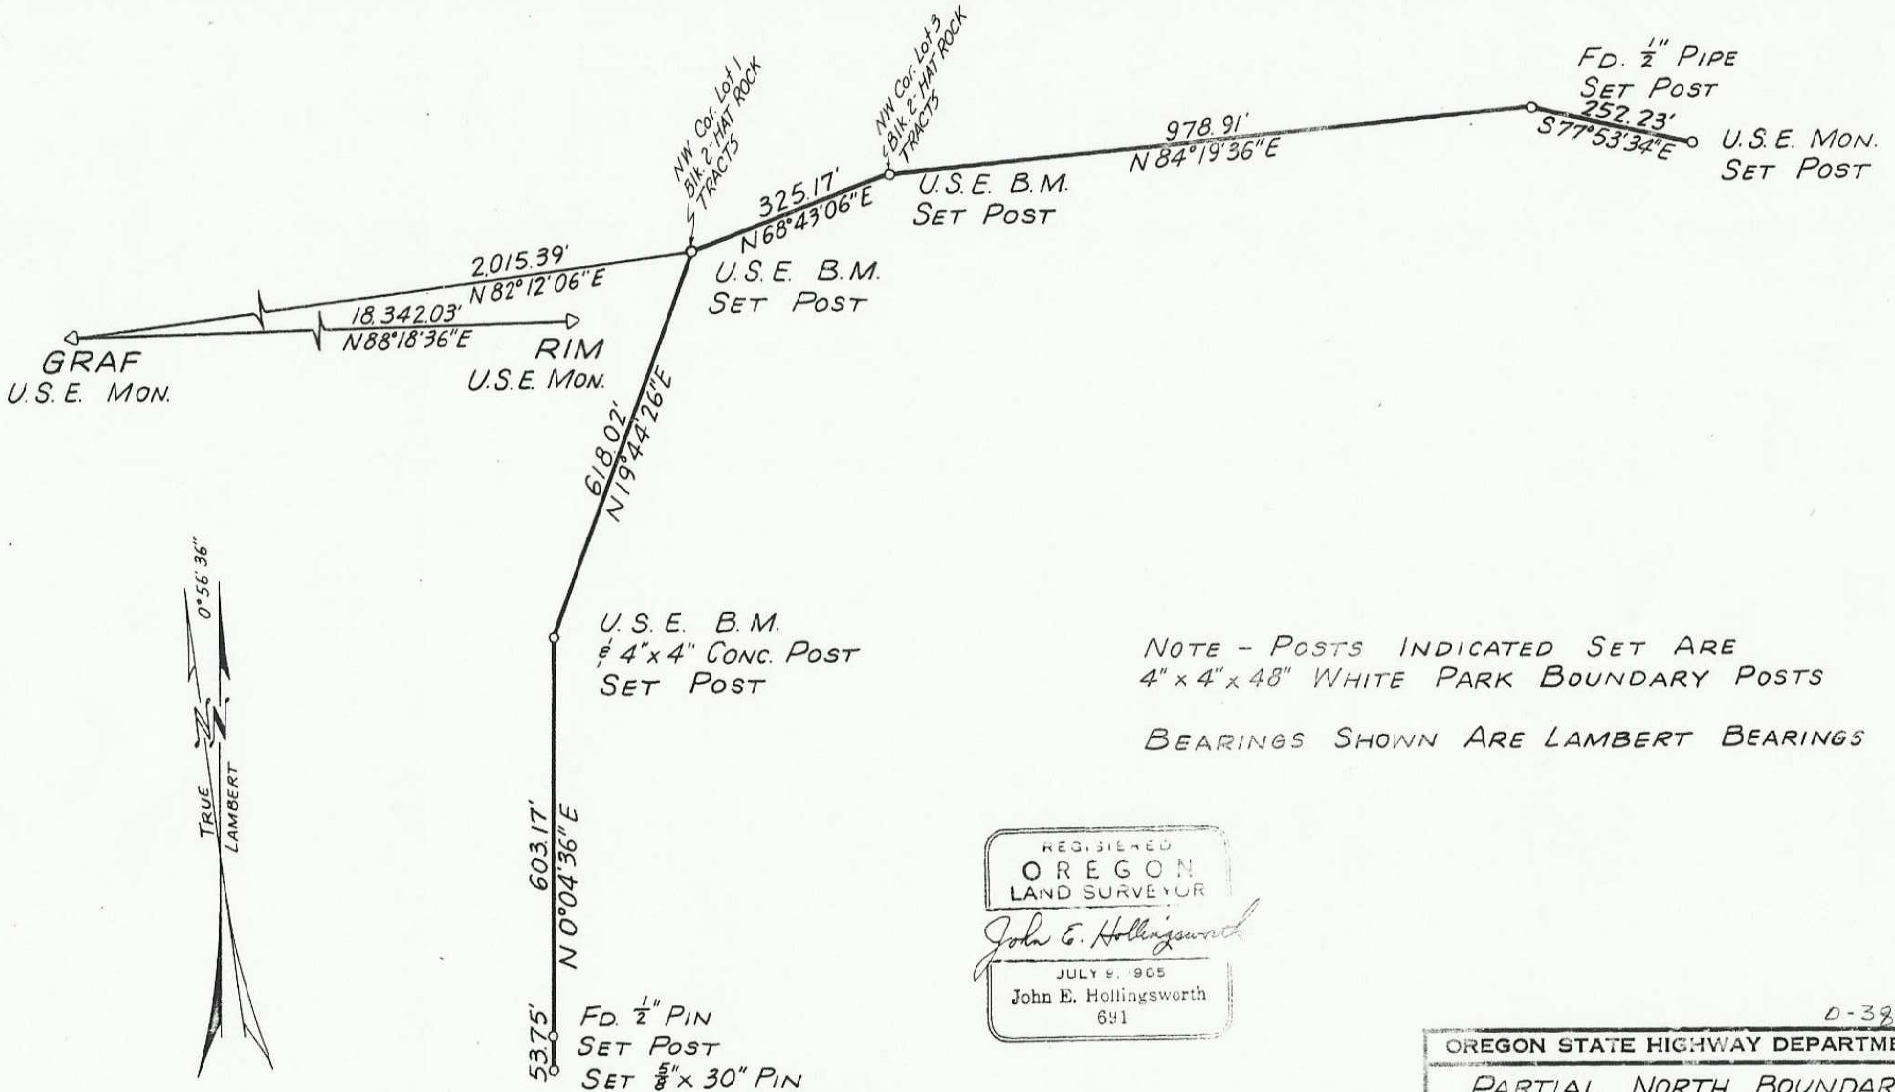

NOTE - POSTS INDICATED SET ARE
4" x 4" x 48" WHITE PARK BOUNDARY POSTS

BEARINGS SHOWN ARE LAMBERT BEARINGS

REGISTERED
OREGON
LAND SURVEYOR
John E. Hollingsworth
JULY 9, 1965
John E. Hollingsworth
691

D-38-A

OREGON STATE HIGHWAY DEPARTMENT	
PARTIAL NORTH BOUNDARY	
For HAT ROCK STATE PARK	
Highway	COLUMBIA RIVER
County	UMATILLA
Scale 1" = 200'	Date 9-27-67

D-38-A