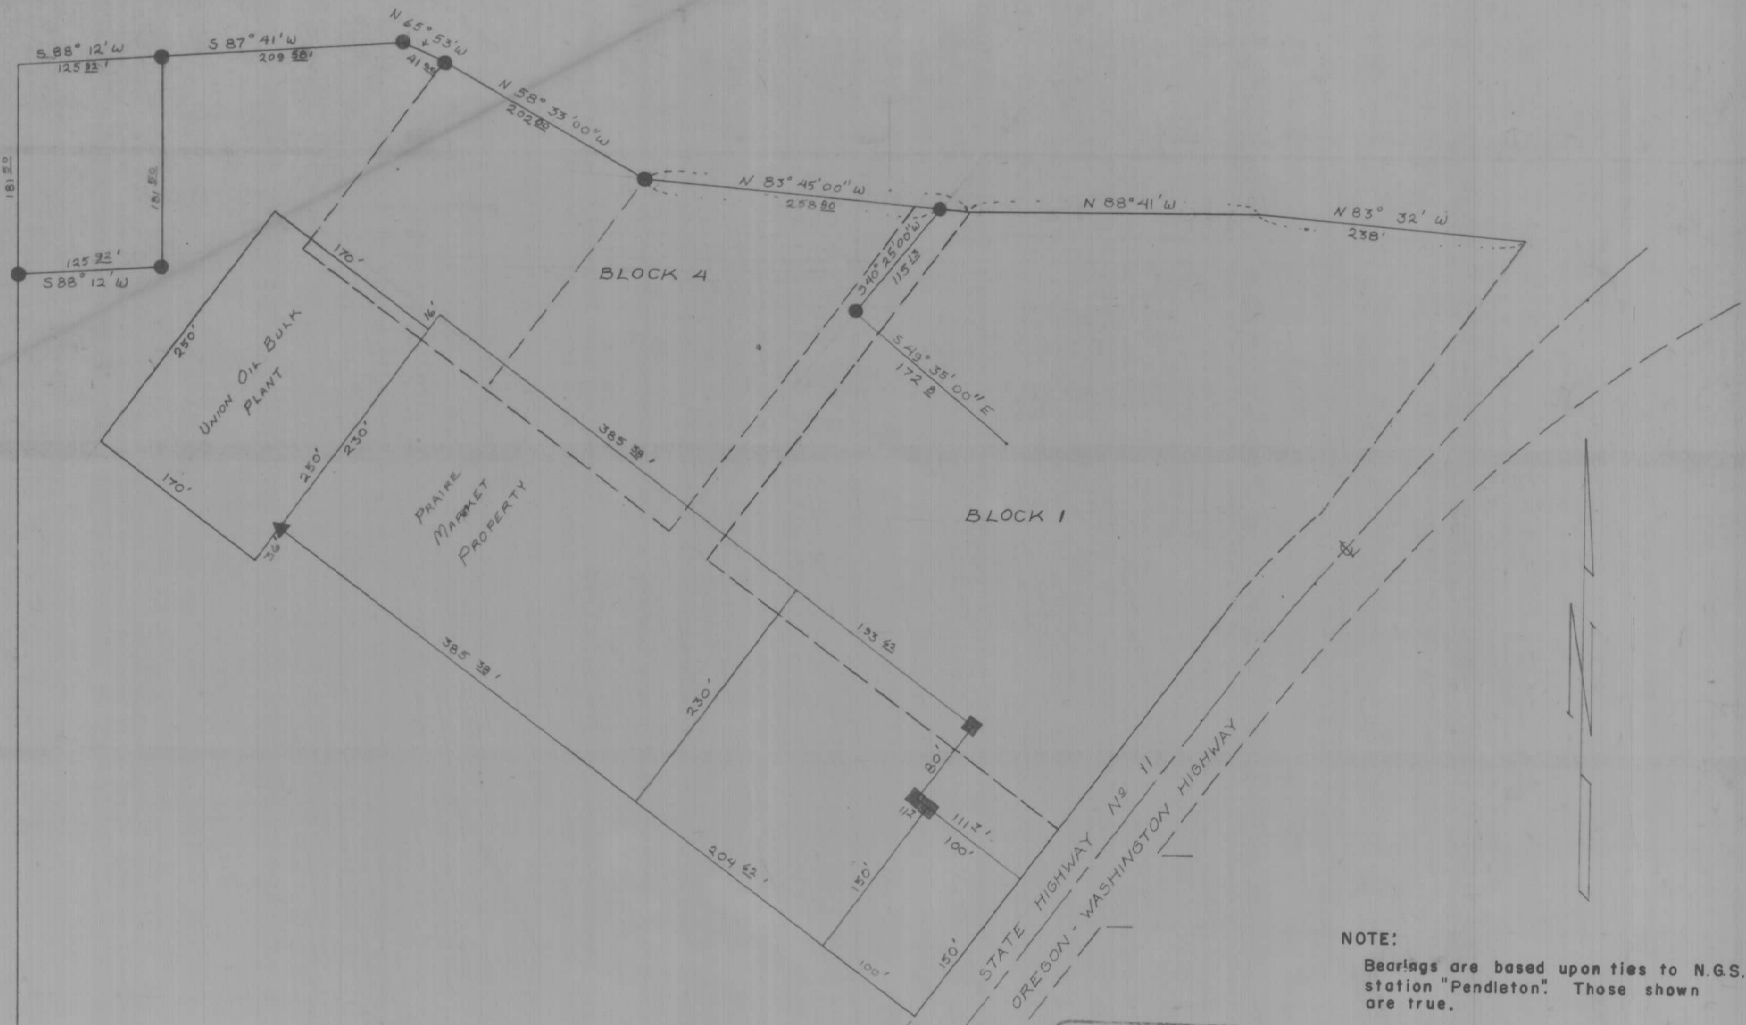

NOTE:

Bearings are based upon ties to N.G.S. station "Pendleton". Those shown are true.

REGISTERED PROFESSIONAL LAND SURVEYOR
David H. Krumbein
OREGON
DAVID H. KRUMBEIN
933

LEGEND

- ● Indicates 5/8" Iron Pin, Set
- ■ Indicates 5/8" Iron Pin, Found
- ▲ Indicates Railroad Spike, Found

I-27-A

SURVEY FOR
PENDLETON SPORTS CENTER
PARCEL IN SE 1/4, SW 1/4, SEC. 1, T2N, R32E

WAYNE HARRIS CO. INC.
ENGINEERS - SURVEYORS

SCALE	1"=100'	DRN. BY	J M B	DRN. NO.
DATE	3-11-74	CKD. BY	D H K	74-267A

I-27-A