

POPLAR AVE.

5" IR

19.85 (50.0)

5" IR

90° 00'

100.06

(North) Bearings are based on "Ekleberry Tract" survey

(150.0)

90° 00'

150.09

100.0


1" 1/2 IR

REGISTERED PROFESSIONAL LAND SURVEYOR

L. Dennis Edwards

OREGON JULY 18, 1971 G. DENNIS EDWARDS 951

11th Street

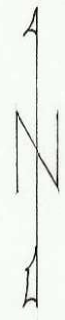

Scale 1" = 20'
● monuments Found
○ 1/2" IR set
(000) of record

Survey for Lee's T.V. in
SE 1/4, Sec 9, T4N, R28E, W.M.
Umatilla Co., Ore. 8/19/75
Denny Edwards PO Box 805, Hermiston

J-26-A

J-26-A