


LEGEND

- - FND 1/4" IRON PIPE
- - SET R.R. SPIKE
- ⊙ - FND 2" PIPE

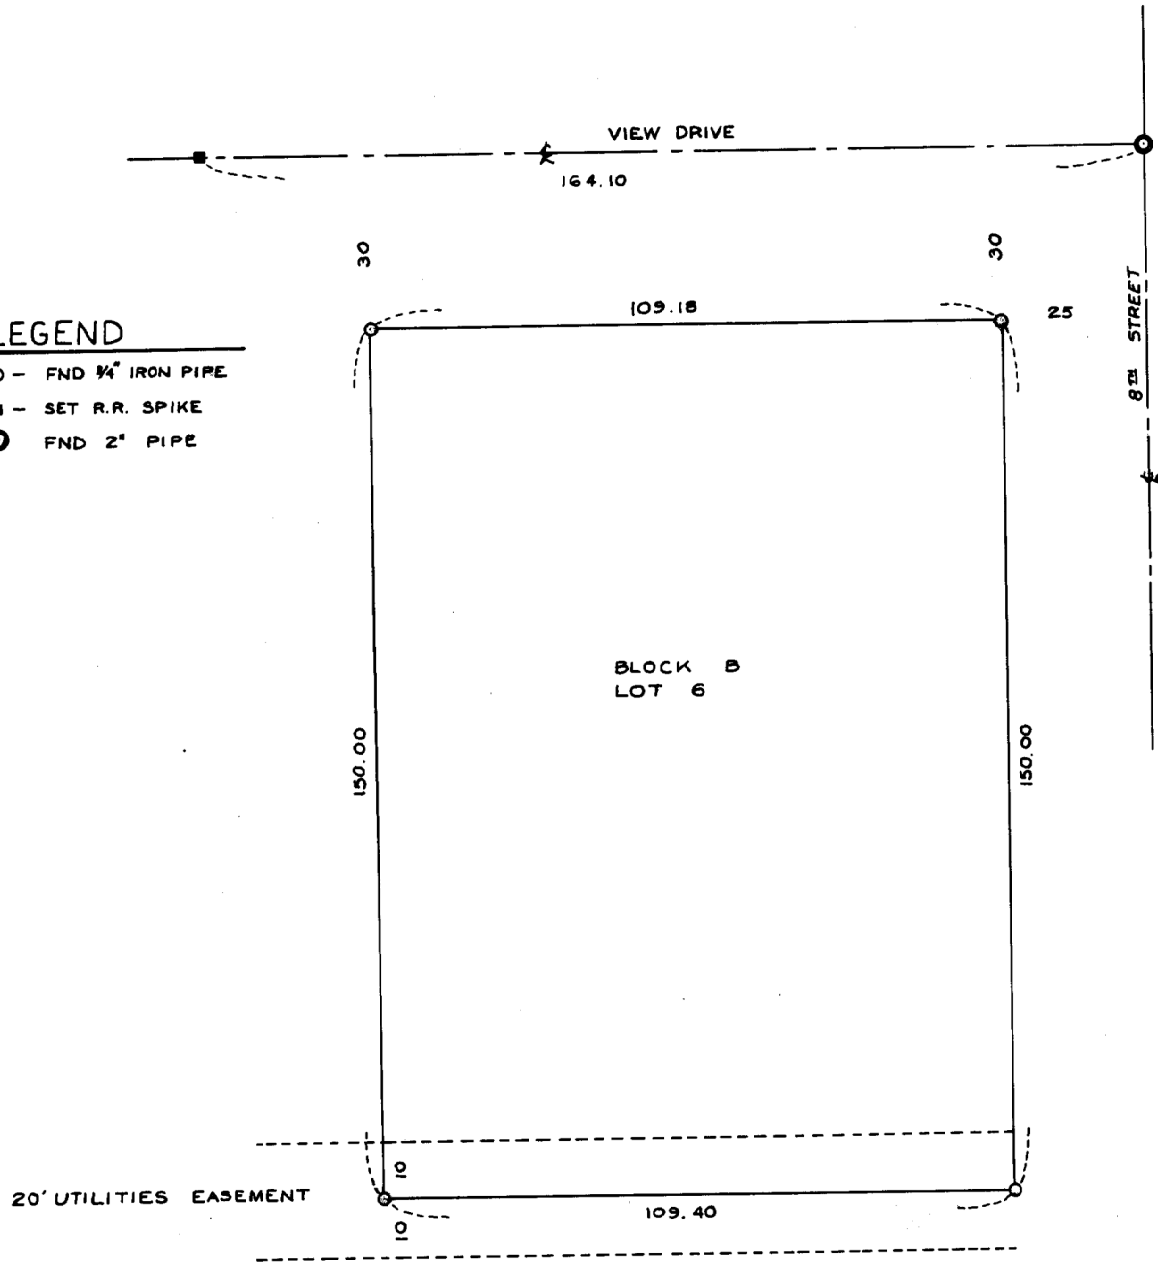

20' UTILITIES EASEMENT

REGISTERED
PROFESSIONAL
LAND SURVEYOR

David H. Krumbein
OREGON
JULY 17, 1970
DAVID H. KRUMBEIN
933

44228 14AC

J-86-A

SURVEY FOR
DUANE ALEXANDER
LOT 6, BLOCK B, PANORAMA HGTS

WAYNE HARRIS CO. INC.			
ENGINEERS - SURVEYORS PENDLETON, OR.			
SCALE	1" = 20'	DRN. BY	DWB
DATE	7-7-75	CKD. BY	DNK
			DRNG. NO. 75-75B